

SURVEY & REMONUMENTATION

FEB 11 1998

SECTION

LAND CORNER RECORDATION CERTIFICATE
Filing Requirement of Act 74, Mich. P.A. 1970

For corners in

<u>Wexford</u> (County)	Located In:	Corner Code #
1. Public Land Survey	T23NR 11W	H-13
	T___R___	_____
	T___R___	_____
	T___R___	_____
2. Property Controlling in Section	S___T___	_____
	S___T___	_____
3. Miscellaneous Property in Sec.	S___T___	_____
	S___T___	_____

RECEIVED

1997 DEC 11 AM 9:32

Linda Loughmiller
WEXFORD COUNTY, MI
REGISTER OF DEEDS

Register of Deeds Stamp & File Number

4. Lot No. _____, Recorded Plat _____
5. Private Claims _____

I, George Smith, in a field survey on 8-26, 1997 do hereby state that under requirements of P.A. 74, Michigan P.A. of 1970, the corner points mentioned in lines 1 and 2 above were in conformance with regulations and rules therefore as required in the current manual of survey instructions of the United States Department of the Interior, Bureau of Land Management or by a decree of a Court of Law and for that the corner points mentioned in lines 3, 4 and 5 above were in conformance with the rules of the Michigan Board of Land Surveyors or by a Decree of a Court of Law; established, re-established, monumented, recovered, found as expressed below:

NOTE: Not more than 2 corners, all in the same town and range, may be recorded on this certificate.

A	B	C	D	E	F	G	H	I	J	K	L	M
1												
2	6	5	4	3	2	1						
3												
4	7	8	9	10	11	12						
5												
6	18	17	16	15	14	13						
7												
8	19	20	21	22	23	24						
9												
10	30	29	28	27	26	25						
11												
12	31	32	33	34	35	36						
13												

A. Description of original monument and accessories and/or subsequent restoration:

- 11-13) 1837 GLO Quarter Section Post by John Brink, Deputy Surveyor, Beech 9" N64½°E 41, Beech 7 N56°W 27
- 1899 Alderman Survey Liber 1, Page 311, no description of Mon. Found, Sugar 20 N46°W 43, Sugar 5, S35°W 46, Southeast corner Section 34 East 39.65 Chains. Southwest corner Section 34, 40 Chains.
- 1966 Griffin RLS #13584 LCRC, Liber 1, Page 463, found 1½" pipe at road intersection, this pipe checks well with local lines of occupation. Replaced pipe with 5"x3" sq. conc. post 1' below surface with 3" Diameter brass disk stamped: T23N-R11W, ¼ S34, S3, T22N RLS#13584 Northwest corner conc. deck of a concrete stoop of a 1st frame house S68°E 117.00', center of 19" Maple N50°W 62.40', Telephone Pole N18°W 77.30' 5"x7", cedar post S45°W 46.7'

B. Description of corner evidence found and/or method applied in restoring or reestablishing corner:

- A(cont.) 19?? WCRC witnesses same as Griffin's LCRC
- 1987 J.L. Wilcox RLS #14102 Certificate of Survey, Liber 2, Page 371, found USFS monument. Witnesses same as 1966 Griffin's LCRC.

Found USFS monument with 3" brass disk stamped T23N, R11W, 1/4, S34, S3, T22N, RLS #13584 ± 4 feet S'ly of centerline road East-West and 4 feet West of centerline road N'ly. This corner is accepted as the best available evidence of the position of the original corner being the quarter corner common to Section 34, T23N-R11W and Section 3, T22N-R11W.

C. Description of monument for corner and accessories established to perpetuate locating the position of the corner:


USFS monument with 3" brass disk

- S47° W 43.78' P.P. set nail
- S68° E 39.53' 3" Apple, set nail
- N71°E 80.76' Corner fence post, set nail
- N17°W 77.53' P.P. set nail

Peer Group Reviewed and Approved

Date: 30 Oct 97
Richard D. Wilcox
Richard D. Wilcox, Wexford County Surveyor

Signed by George D. Smith
Surveyor's Michigan License No. 39098

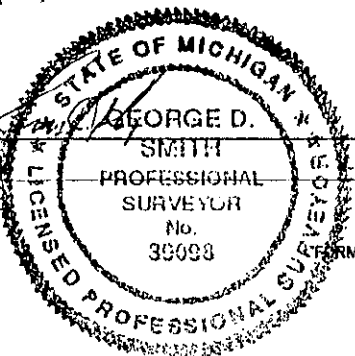

Date 10-30-97