

SURVEY & REMONUMENTATION

FEB 11 1998

LAND CORNER RECORDATION CERTIFICATE Filing Requirement of Act 74, Mich. P.A. 1970

SECTION

For corners in

Wexford

(County)

Located In:

Corner Code #

1. Public Land Survey

T 23N R 11W I-13
 T R _____
 T R _____
 T R _____

2. Property Controlling in Section

S T R _____
 S T R _____

3. Miscellaneous Property in Sec.

S T R _____
 S T R _____

RECEIVED

1997 DEC 11 AM 9:32

Linda Loughmiller
 WEXFORD COUNTY, MI
 REGISTER OF DEEDS

Register of Deeds Stamp & File Number

4. Lot No. _____, Recorded Plat _____
 5. Private Claims _____

I, George D. Smith, in a field survey on 8-26, 1997 do hereby state that under requirements of P.A. 74, Michigan P.A. of 1970, the corner points mentioned in lines 1 and 2 above were in conformance with regulations and rules therefore as required in the current manual of survey instructions of the United States Department of the Interior, Bureau of Land Management or by a decree of a Court of Law and /or that the corner points mentioned in lines 3, 4 and 5 above were in conformance with the rules of the Michigan Board of Land Surveyors or by a Decree of a Court of Law, established, re-established, monumented, recovered, found as expressed below:

NOTE: Not more than 2 corners, all in the same town and range, may be recorded on this certificate.

	A	B	C	D	E	F	G	H	I	J	K	L	M
1													
2		6		5		4		3		2		1	
3													
4		7		8		9		10		11		12	
5													
6		18		17		16		15		14		13	
7													
8		19		20		21		22		23		24	
9													
10		30		29		28		27		26		25	
11													
12		31		32		33		34		35		36	
13													

A. Description of original monument and accessories and/or subsequent restoration:

- I-13) 1837 GLO Section Post by John Brink, Deputy Surveyor; Sugar 18" N36½W 40, Hemlock 16" N12°E 30'
- 1848 GLO Subdivision of T22N-R11W by Orson Lyon, Deputy Surveyor, Ironwood 8" S19½W 22; Beech 13" S29°E 38'
- 1899 Alderman Survey, Liber 1, Page 311, no description of mon. found Sugar 5 S42 E 38'
- 1907 D.E. Teed Survey, Liber 1, page 206, found government witness (NI) and also found stake and Aldermans witness. Sugar 8" N50°E 38', Elm 7" N56½E 79, Sugar 12" N 59½W 78, Sugar 12" S54°W 52½, Beech 14" N6½E 69'
- 1966 Griffin RLS #13584 LCRC, Liber 1, Page 461 found 1½" x 45" iron pipe in centerline of an East-West Road in line with fence South, also found Aldermans witness, replaced pipe with 5" sq.x 5' conc. post with 3" brass disk stamped: T23N-R11W S.C. S.C., S34, S35, 1966 RLS #13584, 9" Maple N31°E, 211.88', Center of 22" Basswood N54 E 71.91' Center of Maple S42°E 25.55', Southwest corner of concrete block house S34°E, 14.5.41', 8" Ash N49°W 184.05' 6"x7" Lib Post North 33'

B. Description of corner evidence found and/or method applied in restoring or reestablishing corner:

A(continued)

- 1973 J.L. Wilcox RLS #14102. Assessor Plat, recorded in Liber 6 of Plats, Pages 290-291 found monument, no witnesses given
- 19?? WCRC witnesses same as 1966 Griffin's LCRC

Found USFS mon. with 3" brass disk in centerline Road East-West and in line with fence to South and 1 of Griffin's witnesses, this corner. This corner is accepted as a careful and faithful perpetuation of the position of the original corner being the corner common to Section 34, T23N-R11W and Sections 3 and 2, T22N-R11W.

C. Description of monument for corner and accessories established to perpetuate locating the position of the corner:


USFS mon. with 3" brass disk

- N55°E 71.60' 24" Basswood (N54°E 71.90' Griffin's witness)
- N13°E 24.94' 8" Basswood set nail
- N53°E 38.28' Top center phone riser
- S18°E 31.25' Top center phone riser
- S40°E 39.08' 18" Maple set nail

Peer Group Reviewed and Approved

Date: 10-30-97
Richard D. Wilcox
 Richard D. Wilcox, Wexford County Surveyor

Signed by George D. Smith
 Surveyor's Michigan License No. 39098

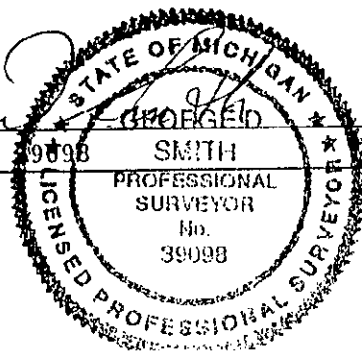

Date 10-30-97