

**SURVEY & REMONUMENTATION**

**FEB 11 1998**

**SECTION**

**LAND CORNER RECORDATION CERTIFICATE**  
Filing Requirement of Act 74, Mich. P.A. 1970

For corners in

<u>Wexford</u> (County)	Located In:	Corner Code #
1. Public Land Survey	T <u>23</u> NR <u>11</u> W	<u>K=13</u>
	T ___ R ___	_____
	T ___ R ___	_____
	T ___ R ___	_____
2. Property Controlling in Section	S ___ T ___ R ___	_____
	S ___ T ___ R ___	_____
3. Miscellaneous Property in Sec.	S ___ T ___ R ___	_____
	S ___ T ___ R ___	_____

RECEIVED

1997 DEC 11 AM 9:32

*Linda Loughmiller*  
WEXFORD COUNTY, MI  
REGISTER OF DEEDS

Register of Deeds Stamp & File Number

4. Lot No. \_\_\_\_\_, Recorded Plat \_\_\_\_\_  
5. Private Claims \_\_\_\_\_

I, George Smith, in a field survey on 8-26, 1997 do hereby state that under requirements of P.A. 74, Michigan P.A. of 1970, the corner points mentioned in lines 1 and 2 above were in conformance with regulations and rules therefore as required in the current manual of survey instructions of the United States Department of the Interior, Bureau of Land Management or by a decree of a Court of Law and/or that the corner points mentioned in lines 3, 4 and 5 above were in conformance with the rules of the Michigan Board of Land Surveyors or by a Decree of a Court of Law; established, re-established, monumented, recovered, found as expressed below:

NOTE: Not more than 2 corners, all in the same town and range, may be recorded on this certificate.

A	B	C	D	E	F	G	H	I	J	K	L	M
1												
2	6		5		4		3		2		1	
3												
4	7		8		9		10		11		12	
5												
6	18		17		16		15		14		13	
7												
8	19		20		21		22		23		24	
9												
10	30		29		28		27		26		25	
11												
12	31		32		33		34		35		36	
13												

**A. Description of original monument and accessories and/or subsequent restoration:**

- K-13) 1837 GLO Section Post by John Brink, Deputy Surveyor; Sugar 18 N13°E 45, Hemlock 12, N74°W 20
- 1848 GLO Subdivision of T22N-R11W by Orson Lyon, Deputy Surveyor; Birch 26, S33°W 26, Sugar 10, S5°E 39
- 1907 D.E. TED Survey Liber 1, Page 206, Fd wagon skein set by Devoc from 2 government witnesses - Sugar NE, Birch SW Hemlock 14 S77°E 117 Sugar 14 S53°E 77½
- 1922 WCRC witnesses, no description of monument given, 7" Maple S8°E 25.41', 7" Maple S28°W 50.23' 8" Maple N18°W 35.20'
- 1973 J.L. Wilcox RLS # 14102 Survey for Assessor Plat in Section 2, T22N, R11W, Field Book 68, Page 4, found old wagon skein and crockery, replaced with Wexford County mon. S08°E 12" Maple 25.34', S28°W 8" Maple 33.24', N18°W 16" Maple 35.00'

**B. Description of corner evidence found and/or method applied in restoring or reestablishing corner:**

Found Wexford County mon. 1' Northerly of Southerly edge 2-track and 3 witness from 1973 Wilcox Survey, this corner is accepted as a careful and faithful perpetuation of the position of the original corner being the section corner common to Sections 35 & 36, T23N-R11W and Sections 1 and 2, T22N-R11W.

**C. Description of monument for corner and accessories established to perpetuate locating the position of the corner:**


Wexford County Mon.

- N70°E 44.49' 8" Maple (fd. nail)
- S10°E 25.18' 14" Maple (fd. nail)
- S28°W 33.21' 10" Maple (fd. nail)
- N20°W 35.10' 20" Maple

Peer Group Reviewed and Approved

Date: 10-30-97  
*Richard D. Wilcox*  
Richard D. Wilcox, Wexford County Surveyor

Signed by George Smith  
Surveyor's Michigan License No. 39098

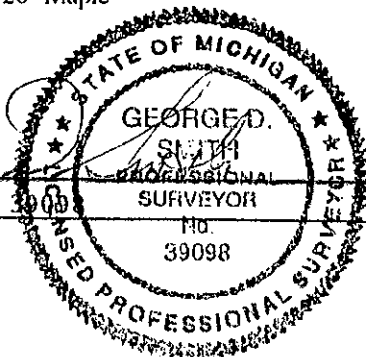

Date 10-30-97