

# SURVEY & REMONUMENTATION

**FEB 11 1998**

## LAND CORNER RECORDATION CERTIFICATE Filing Requirement of Act 74, Mich. P.A. 1970

For corners in <b>SECTION</b> <u>Wexford</u> (County)	Located In:	Corner Code #
1. Public Land Survey	T <u>23N</u> R <u>11W</u> T _____ R _____ T _____ R _____ T _____ R _____	<u>L-13</u> _____ _____ _____
2. Property Controlling in Section	S _____ T _____ R _____ S _____ T _____ R _____	_____ _____
3. Miscellaneous Property in Section	S _____ T _____ R _____ S _____ T _____ R _____	_____ _____
4. Lot No. _____, Recorded Plat _____		
5. Private Claims _____		

**RECEIVED**

1997 DEC 11 AM 9:32

*Linda Loughmiller*

WEXFORD COUNTY, MI  
REGISTER OF DEEDS

**Register of Deeds Stamp & File Number**

	A	B	C	D	E	F	G	H	I	J	K	L
2	6		5		4		3		2		1	
3												
4	7		8		9		10		11		12	
5												
6	18		17		16		15		14		13	
7												
8	19		20		21		22		23		24	
9												
10	30		29		28		27		26		25	
11												
12	31		32		33		34		35		36	
13												

I, George Smith, in a field survey on 7-22, 1997, do hereby certify that under requirements of P.A. 74, Michigan P.A. of 1970, the corner points mentioned in lines 1 and 2 above were in conformance with regulations and rules therefore as required in the current manual of survey instructions of the United States Department of the Interior Bureau of Land Management or by a decree of a Court of Law and/or that the corner points mentioned in lines 3, 4 and 5 above were in conformance with the rules of the Michigan Board of Professional Surveyors or by a Decree of a Court of Law; established, re-established, monumented, re-monumented, recovered, found as expressed below:

**NOTE: Not more than 4 corners, all in the same town and range, may be recorded on this certificate.**

**A. Description of original monument and accessories and/or subsequent restoration:**

- L-13) 1837 GLO Quarter Section Post by John Brink, Deputy Surveyor; Beech 7 N51°E 19, Sugar 10 N09°W 39
- 1949 M.S.H.D. plans project 83-23 Found 3/4" pipe 4" Maple S07°E 28.27, 6" Maple S31°W 52.42, 10" Maple N20°W 38.44
- 19?? WCRC witnesses, witnesses same as 1949 MSHD

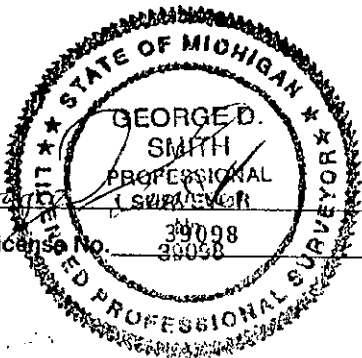
**B. Description of corner evidence found and/or method applied in restoring or reestablishing corner:**

- L-13) Found 3/4" pipe in center of East-West trail and 1 witness from 1949 MSHD plans. This corner is accepted as the best available evidence of the position of the original corner being the quarter section corner common to Section 36, T23N-R11W and Section 1, T22N-R11W

**C. Description of monument for corner and accessories established to perpetuate locating the position of the corner:**

- L-13) Set 5/8"x8" iron with Wexford County Brass Cap stamped S 1/4 36 1997 PS #39098 in center of existing 3/4" pipe
  - N10°W 21.28 16" Tw. cherry, found spk.
  - N46°E 44.96 10" Maple
  - S05°E 28.29 12" Maple, found spk, (28.27 MSHD)
  - S51°W 21.46 10" Ash, set spk.

Peer Group Reviewed and Approved  
 Date 10-30-97  
*Richard D. Wilcox*  
 Richard D. Wilcox, Wexford County Surveyor

Signed by *George Smith*  
 Surveyor's Michigan License No. 39098  


Date 10-30-97