

JAN 17 1996

COMMISSION

LAND CORNER RECORDATION CERTIFICATE  
Filing Requirement of Act 74, Mich. P.A. 1970

For corners in  
Wexford

(County)

Located In:

Corner Code #

1. Public Land Survey	T 23N R 11W	M-2
	T _____ R _____	_____
	T _____ R _____	_____
	T _____ R _____	_____
2. Property Controlling in Section	S _____ T _____ R _____	_____
	S _____ T _____ R _____	_____
3. Miscellaneous Property in Sec.	S _____ T _____ R _____	_____
	S _____ T _____ R _____	_____

4. Lot No. \_\_\_\_\_, Recorded Plat \_\_\_\_\_  
5. Private Claims \_\_\_\_\_

RECEIVED

1995 DEC 14 PM 3:49

*Linda Dougherty*  
WEXFORD COUNTY, MI  
REGISTER OF DEEDS

Register of Deeds Stamp & File Number

I, George D. Smith, in a field survey on November 21, 19 95, do hereby certify that under requirements of P.A. 74, Michigan P.A. of 1970, the corner points mentioned in lines 1 and 2 above were in conformance with regulations and rules therefore as required in the current manual of survey instructions of the United States Department of the Interior, Bureau of Land Management or by a decree of a Court of Law and/or that the corner points mentioned in lines 3, 4 and 5 above were in conformance with the rules of the Michigan Board of Land Surveyors or by a Decree of a Court of Law; established, re-established, monumented, re-monumented, recovered, found as expressed below:

**NOTE: Not more than 4 corners, all in the same town and range, may be recorded on this certificate.**

A	B	C	D	E	F	G	H	I	J	K	L	M
2	6	5	4	3	2	1						
3												
4	7	8	9	10	11	12						
5												
6	18	17	16	15	14	13						
7												
8	19	20	21	22	23	24						
9												
10	30	29	28	27	26	25						
11												
12	31	32	33	34	35	36						
13												

A. Description of original monument and accessories and/or subsequent restoration:

1838 GLO Quarter Section post by John Brink, Deputy Surveyor, Hemlock 28 S 84°W 25, Sugar 10, N 11½° W 47  
1886 A.J. Teed Survey recorded in Liber 1, Page 284, corner found but no description or witnesses given

B. Description of corner evidence found and/or method applied in restoring or reestablishing corner:


Set 5/8" x 36" Iron in center of old lane and ±3' East of North-South Fence by single proportionate measure between found Northeast Corner Section 1 and found Southeast corner, Section 1. This corner is accepted as a careful and faithful re-establishment of the position of the original corner, being the quarter corner common to Section 1, T23N, R11W and Section 6, T23N, R10W.

Peer Group Reviewed and Approved

Date: 8 Dec 95  
*Richard D. Wilcox*  
Richard D. Wilcox, Wexford County Surveyor

C. Description of monument for corner and accessories established to perpetuate locating the position of the corner:

Set 5/8" x 36" iron with Wexford County brass cap stamped E 1/4 1, 1995 PS 39098  
N 30° W 25.56' 12" Cherry  
S 55° W 20.15' 20" Beech  
S 10° E 37.47' 5" Maple  
N 40° E 23.99' 20" Maple

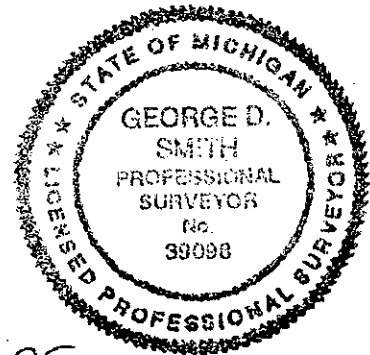

Signed by *George D. Smith*  
Surveyor's Michigan License No. 39098

Date 12-14-95