

RECEIVED

1995 DEC 14 PM 3:49

JAN 17 1996

LAND CORNER RECORDATION CERTIFICATE

Filing Requirement of Act 74, Mich. P.A. 1970

For corners in COMMISSION Wexford (County)

Located In:

Corner Code #

Linda Longmiller WEXFORD COUNTY, MI REGISTER OF DEEDS

Table with 4 columns: Survey Type, T, R, Corner Code #. Rows include Public Land Survey, Property Controlling in Section, Miscellaneous Property in Section.

Register of Deeds Stamp & File Number

4. Lot No. Recorded Plat
5. Private Claims

I, George D. Smith, in a field survey on July 14, 1995, do hereby certify that under requirements of P.A. 74, Michigan P.A. of 1970, the corner points mentioned in lines 1 and 2 above were in conformance with regulations and rules therefore as required in the current manual of survey instructions of the United States Department of the Interior, Bureau of Land Management or by a decree of a Court of Law and/or that the corner points mentioned in lines 3, 4 and 5 above were in conformance with the rules of the Michigan Board of Professional Surveyors or by a Decree of a Court of Law; established, re-established, monumented, re-monumented, recovered, found as expressed below:

Grid table with columns A-L and rows 2-12. Contains numbers 1-36.

NOTE: Not more than 4 corners, all in the same town and range, may be recorded on this certificate.

A. Description of original monument and accessories and/or subsequent restoration:

- 1838 GLO Section post by John Brink, Deputy Surveyor, Beech 10 S 32°W 55, Elm 16 N 49° W 70
1852 GLO Subdivision of Section 7 & 18, T23N-R11W by L.S. Scranton, Deputy Surveyor Hemlock 20 N77°E 44, Beach 10, S 47° E 37
1901 Devoe Survey recorded in Liber 1, Page 309, Corner found, no description of corner was given, Witnesses: R.Elm 8 N 85° W 47, Sugar 15 S 60° E 48.
1973 Wilcox Associates Certificate of Survey, By J.L. Wilcox, PS #14102, Liber 1, Page 67, Found 1" x 1/2" bar, N 85° W 18" Maple 39.42' N 45° E 12" Oak 40.06' S 55° E 8" Maple 39.84'.

"A" continued on back.

B. Description of corner evidence found and/or method applied in restoring or reestablishing corner:


Found 1/2" iron and cap #14102 in Centerline road North-South and in centerline road to East, also found axle shaft Southeasterly 14.55' from 1/2" iron. Accepted position of 1/2" iron and cap #14102 as the best available evidence of the position of the original corner, being the section corner common to Sections 12 and 13, T23N, R11W and Sections 7 and 18, T23N, R10W.

Peer Group Reviewed and Approved

Date: 9 Dec 95
Richard D. Wilcox, Wexford County Surveyor

C. Description of monument for corner and accessories established to perpetuate locating the position of the corner:

- Replace 1/2" iron and cap with 5/8" x 36" iron with Wexford County brass cap stamped Southeast 13, 1995, PS #39098
N 78°W 38.97' 20" Maple
S 40°W 59.08' 18" Maple
N 76°E 47.23' 12" Maple
S 45°E 45.32' Power Pole
S 20°E 14.55' axle shaft (pulled)

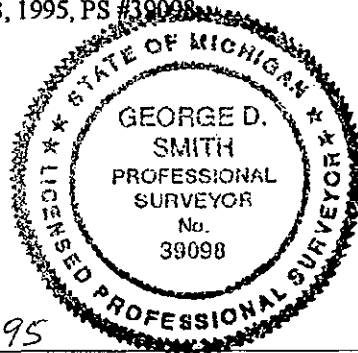

Signed by George D. Smith
Surveyor's Michigan License No. 39098

Date 12-14-95

1973 Wilcox Assoc. L.C.R.C., by J. Erickson PS# 16929 Liber 2, Page 598, Found 1" iron strip and ½" iron, raised with Wexford County Monument S 60° E 7" Maple 39.83' N 50° E 7" Elm 40.13'

1973 Wilcox Assoc. Certificate of Survey, by J. Erickson PS# 16929 Liber 1, Page 119, found iron set Wexford County Monument

1979 Wilcox Assoc. Certificate of Survey, by J.L. Wilcox PS# 14102 Liber 1, Page 726, found Wexford County Monument

1983 Wilcox Assoc. Certificate of Survey, by J.L. Wilcox PS# 14102 Liber 2, Page 06, found Wexford County Monument

1988 Wilcox Assoc. Certificate of Survey, by D.E. Schripsema PS# 24617 Liber 66, Page 517 found Wexford County Monument

1991 Wilcox Assoc. Certificate of Survey, by J.D. Geers PS# 33977 Liber 71, Page 397 found Wexford County Monument

1993 Wilcox Assoc. Certificate of Survey, J.D. Geers, PS# 33977 Liber 72, Page 922 found Wexford County Monument in poor condition raised with ½" iron and cap # 14102, ±3' E'y, centerline road North-South and in centerline trail road E'ly. N 44° W 49.41' center of phone riser, N 73° E 47.20' 12" Maple