

JAN 17 1996

COMMISSION

LAND CORNER RECORDATION CERTIFICATE  
Filing Requirement of Act 74, Mich. P.A. 1970

RECEIVED

1995 DEC 14 PM 3:50

For corners in

Wexford  
(County)

Located In:

Corner Code #

- 1. Public Land Survey      T 23N R 11W      M-10
- T    R
- T    R
- T    R
- 2. Property Controlling    S    T    R
- in Section                S    T    R
- 3. Miscellaneous            S    T    R
- Property in Sec.        S    T    R
- 4. Lot No. \_\_\_\_\_, Recorded Plat \_\_\_\_\_
- 5. Private Claims \_\_\_\_\_

*Linda Doughmiller*  
WEXFORD COUNTY, MI  
REGISTER OF DEEDS

Register of Deeds Stamp & File Number

	A	B	C	D	E	F	G	H	I	J	K	L	M
2	6	5	4	3	2	1							
3													
4	7	8	9	10	11	12							
5													
6	18	17	16	15	14	13							
7													
8	19	20	21	22	23	24							
9													
10	30	29	28	27	26	25							
11													
12	31	32	33	34	35	36							
13													

I, George D. Smith in a field survey on December 7, 1995, do hereby certify that under requirements of P.A. 74, Michigan P.A. of 1970, the corner points mentioned in lines 1 and 2 above were in conformance with regulations and rules therefore as required in the current manual of survey instructions of the United States Department of the Interior, Bureau of Land Management or by a decree of a Court of Law and/or that the corner points mentioned in lines 3, 4 and 5 above were in conformance with the rules of the Michigan Board of Land Surveyors or by a Decree of a Court of Law; established, re-established, monumented, re-monumented, recovered, found as expressed below:

**NOTE: Not more than 4 corners, all in the same town and range, may be recorded on this certificate.**

A. Description of original monument and accessories and/or subsequent restoration:

1838 GLO Quarter Section post by John Brink, Deputy Surveyor, Maple 10 S 11°W 31, Beech 14 N 78½°W 33


B. Description of corner evidence found and/or method applied in restoring or reestablishing corner:

Set 5/8" x 36" iron with Wexford County brass cap stamped East 1/4 25, 1995; PS #39098 by single proportionate measure between found Southeast Corner Section 13 and the re-established Southeast Corner Section 36, T23N-R11W. This corner is accepted as a careful and faithful re-establishment of the position of the original corner, being the 1/4 corner common to Section 25, T23N, R11W and Section 30, T23N, R10W.

Peer Group Reviewed and Approved  
Date: Dec 9 5  
*Richard D. Wilcox*  
Richard D. Wilcox, Wexford County Surveyor

C. Description of monument for corner and accessories established to perpetuate locating the position of the corner:

5/8" x 36" iron with Wexford County Brass Cap in centerline 2-track  
S 25° E 38.75' 24" Hemlock  
S 70° E 29.72' 7" Maple  
N 82° W 34.02' 10" Cherry  
N 15° W 53.95' 14" Cherry

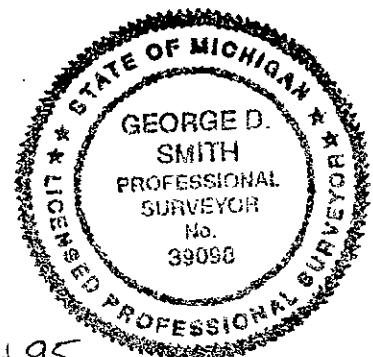

Signed by *George D. Smith*  
Surveyor's Michigan License No. 39098

Date 12-14-95