

SURVEY & RECORDATION

JAN 17 1996

LAND CORNER RECORDATION CERTIFICATE
COMMISSION Filing Requirement of Act 74, Mich. P.A. 1970

RECEIVED

1995 DEC 14 PM 3:50

For corners in Wexford Located In: _____ Corner Code # _____
(County)

Linda Dougherty
WEXFORD COUNTY, MI
REGISTER OF DEEDS

- 1. Public Land Survey T 23N R 11W M-11
T _____ R _____
T _____ R _____
T _____ R _____
- 2. Property Controlling S _____ T _____ R _____
In Section S _____ T _____ R _____
- 3. Miscellaneous S _____ T _____ R _____
Property in Section S _____ T _____ R _____

Register of Deeds Stamp & File Number

- 4. Lot No. _____, Recorded Plat _____
- 5. Private Claims _____

A	B	C	D	E	F	G	H	I	J	K	L	M
2	6	5	4	3	2	1						
3												
4	7	8	9	10	11	12						
5												
6	18	17	16	15	14	13						
7												
8	19	20	21	22	23	24						
9												
10	30	29	28	27	26	25						
11												
12	31	32	33	34	35	36						
13												

I, George D. Smith, in a field survey on December 7, 1995, do hereby certify that under requirements of P.A. 74, Michigan P.A. of 1970, the corner points mentioned in lines 1 and 2 above were in conformance with regulations and rules therefore as required in the current manual of survey instructions of the United States Department of the Interior, Bureau of Land Management or by a decree of a Court of Law and/or that the corner points mentioned in lines 3, 4 and 5 above were in conformance with the rules of the Michigan Board of Professional Surveyors or by a Decree of a Court of Law; established, re-established, monumented, re-monumented, recovered, found as expressed below:

NOTE: Not more than 4 corners, all in the same town and range, may be recorded on this certificate.

A. Description of original monument and accessories and/or subsequent restoration:

1838 GLO Section post by John Brink, Deputy Surveyor, Sugar 11 S 29 1/2°W 25, Sugar 14 N 13° W 37
1852 GLO Subdivision of Section 30 and 31 T23N-R10W by L.S. Scranton Deputy Surveyor Hemlock 8, S36°E 35,
Beech 12, N 79°E 38

B. Description of corner evidence found and/or method applied in restoring or reestablishing corner:


Set 5/8" x 36" iron with Wexford County brass cap stamped Southeast 25, 1995, PS #39098 by single proportionate measure between found Southeast Corner Section 13 and the re-established Southeast Corner Section 36, T23N-R11W. Corner falls ±36 North of fence line to East, fence curves Northward as it continues to East. This corner is accepted as a careful and faithful re-establishment of the position of the original corner common to Sections 25 and 36, T23N-R11W and Section 31, T23N-R10W.

Peer Group Reviewed and Approved

Date: 14 Dec 95
Richard D. Wilcox
Richard D. Wilcox, Wexford County Surveyor

C. Description of monument for corner and accessories established to perpetuate locating the position of the corner:

5/8" x 36" iron with Wexford County Brass Cap.
S 25° E 19.60' 5" Ironwood
S 75° W 35.30' TW. 5" Ironwood
N 5° E 14.35' 5" Maple
N 80° E 10.37' 10" Cherry
Centerline 2-track ± 18' W'y

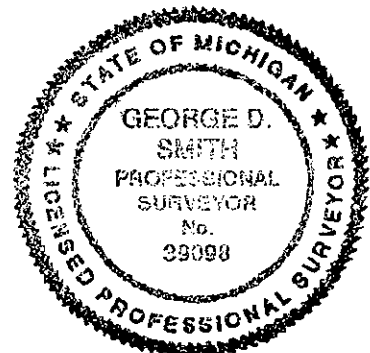

Signed by George D. Smith
Surveyor's Michigan License No. 39098

Date 12-14-95