

STATE OF MICHIGAN
DEPARTMENT
OF
NATURAL RESOURCES

LAND CORNER RECORD


WEXFORD COUNTY
T 24 N R 9 W

DESCRIPTION OF CORNER SE corner, Section 20

CORNER MONUMENT Left Angle Iron in place

DATE MONUMENT PLACED AND WITNESSED 10-6-71

WITNESSES TO CORNER..... 32" Elm N 47 E 42.60'

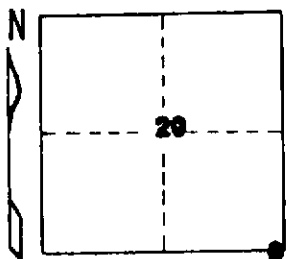

34" Maple N 41 W 134.60'


Telephone pole S 56 W 52.45'

AND Ctr. E-W Black top road Due S 0.5'

CIRCLE CORNER REGISTERED

DESCRIPTION IN DETAIL AS TO HOW CORNER WAS LOCATED AND IDENTIFIED OR RESTORED.

Found 1 1/4" Angle iron as recovered and witnessed by M.S.N.D. in 1957, in line with gravel road to South and dirt road to North.

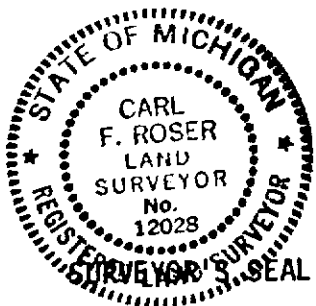

DISTRIBUTION:

SIGNED

Carl F. Roser
REGISTERED LAND SURVEYOR 12028

DATE

10-15-71

County Courthouse
Area Forester (Regions I & II)
District or Region Surveyor
Forestry Div., Lansing

R 4047
Rev. 10/68