

STATE OF MICHIGAN
DEPARTMENT
OF
NATURAL RESOURCES

LAND CORNER RECORD

WEDFORD COUNTY


T 24 N R 9 W

DESCRIPTION OF CORNER NW CORNER, SECTION 16

CORNER MONUMENT Added D.N.R. Monument & Cedar Post

DATE MONUMENT PLACED AND WITNESSED 10-8-71

WITNESSES TO CORNER.....

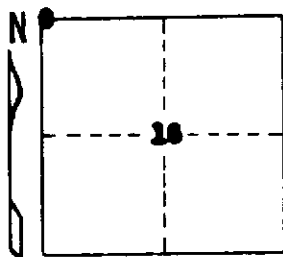

10" V. Pine S 75 W 64.3'


6" V. Pine S 18 E 14.6'

AND
Ctr. N-S Dist Rd. Due W. 205'

CIRCLE CORNER REGISTERED

DESCRIPTION IN DETAIL AS TO HOW CORNER WAS LOCATED AND IDENTIFIED OR RESTORED.

Recovered "Targe" corner (3/4" pipe) as recovered and witnessed by N.S.M.D. in 1957.

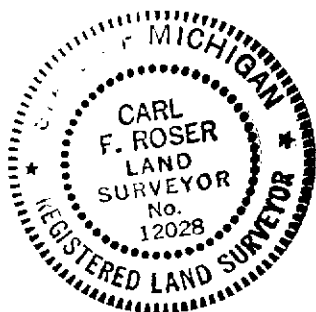

SURVEYOR'S SEAL

SIGNED

Carl F. Roser
REGISTERED LAND SURVEYOR 12028

DATE

10/18/71

DISTRIBUTION:

County Courthouse
Area Forester (Regions I & II)
District or Region Surveyor
Forestry Div., Lansing

R 4047
Rev. 10/68