

STATE OF MICHIGAN
DEPARTMENT
OF
NATURAL RESOURCES

LAND CORNER RECORD

WEXFORD COUNTY


T 24 N R 9 W

DESCRIPTION OF CORNER SW Corner, Section 15

CORNER MONUMENT Added P.N.R. Monument & Cedar Post

DATE MONUMENT PLACED AND WITNESSED 10-9-71

WITNESSES TO CORNER..... 10" Cedar S 24 E 27.7'

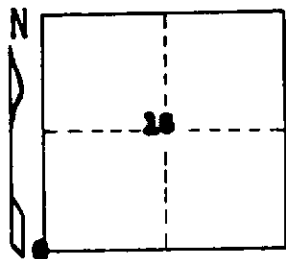

9" W. Pine S 39 W 10.4'


8" W. Pine S 51 E 10.4'

AND Ctr. N-S R.R. Track Duo W 65'
Ctr. N-S Dirt Rd. Duo E. 127'

CIRCLE CORNER REGISTERED

DESCRIPTION IN DETAIL AS TO HOW CORNER WAS LOCATED AND IDENTIFIED OR RESTORED.

Recovered 2" pipe (Schoaf Corner) as recovered and witnessed by N.S.M.D. in 1957;
in line with center of dirt road to East. Corner fits Fudge Witness.

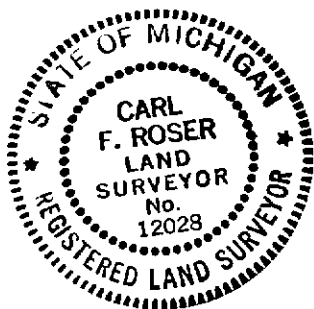

SURVEYOR'S SEAL

SIGNED

Carl F. Roser

DATE

10-15-71

DISTRIBUTION:

REGISTERED LAND SURVEYOR **12028**

County Courthouse
Area Forester (Regions I & II)
District or Region Surveyor
Forestry Div., Lansing

R 4047
Rev. 10/68