

LAND CORNER RECORDATION CERTIFICATE

FILING REQUIREMENT OF ACT 74, MICH. P.A.1970

FOR CORNERS OF--:	LOCATED IN--:	CORNER CODE NUMBER
1. PUBLIC LAND SURVEY	T. 24 N. R. 9 W.	C-10; C-11
2. PROPERTY CONTROLLING IN SECTION 30	T. 24 N. R. 9 W.	5
3. MISCELLANEOUS PROPERTY IN SECTION 30	T. 24 N. R. 9 W.	XX = 652.94' E of #5
4. LOT NO. _____, RECORDED PLAT _____		
5. PRIVATE CLAIMS _____		

REGISTER OF DEEDS STAMP AND FILING NUMBER

I, Carl F. Roser, do hereby certify that under requirements of P.A. 74, Michigan P.A. of 1970 the corner points mentioned in lines 1 and 2 above were, in a field survey on May 7, 1980, established, re-established, monumented, re-monumented, recovered or restored as expressed below and in conformance with regulations and rules therefore as required in the current manual of survey instructions of the United States Department of the Interior Bureau of Land Management or by a decree of a court of law. Furthermore, that the corner points mentioned in lines 3 and 5 above were, in a field survey on May 7, 1980, found, recovered, restored, established or re-established as expressed below and in conformance with the rules of the Michigan State Board of Registration for Land Surveyors or, by Decree of a Court of law:

A. Description of original monument and accessories and/or subsequent restorations:
C. (continued)

XX
Set 1 1/4"x6' pipe & cedar post w/loc. tag
3" Maple S54°W 48.3
13" W. Pine S89°W 75.9
Fd. 2" pipe (flush w/ground)
S61°27'W 44.1
N-S fence West 38'±

B. Description of corner evidence found and/or method applied in restoring or re-establishing corner:

C-10 Corner reestablished S.P. to Teed (1895) between fd. sec. corners 1/2 mile N & 1/2 mile S. Corner falls in center N-S gravel road.

C-11 Fd. & accepted Wex. Co. Mon. for SE corner S-30. Corner is in approximate intersection of N-S-E-W gravel roads.

5 Set 1/8 corner per standard BLM instructions. Fd. 2" pipe; at fn. corner, fn. N & E; is S22°08'W 27.80', drove pipe down flush with ground.

XX Established NE corner of W 1/2 SW 1/4 NE 1/4 of S-30 per standard BLM instructions. Corner falls in wet marshy hole.

C. Description of monument for corner and accessories established to perpetuate locating the position of the corner:

C-10	C-11	5
Set Wexford County Monument	Fd. Wex. Co. Mon. (buried 0.4)	Set 5/8"x36" rerod w/RLS
5" Maple S20°E 42.01	Power Pole S56°W 49.57	Cap & ced.post w/loc.tag
8" Maple S70°E 50.44	7" W. Birch N10°W 50.64	6" Cherry S47°W 29.3
8" Twin Ced. S40°W 43.97	10" Maple S50°E 58.84	19" Twin Ch. S50°E 48.8
Set cedar post w/loc. tag	1" pipe (1' above ground)	18" Triple Cherry
West 33'	S39°E 45.70	N34°W 67.4
	Set ced.post w/loc.tag	
	N45°W 47'	

SIGNED BY Carl F. Roser 7-23-80 DATE

SURVEYOR'S MICHIGAN REGISTRATION NO. 12028


FOR STATE AND UNITED STATES AGENCIES:

SIGNED BY _____ DATE _____

CHIEF OF SURVEY PARTY

APPROVED AND SIGNED BY _____ DATE _____

MICHIGAN REGISTERED LAND SURVEYOR

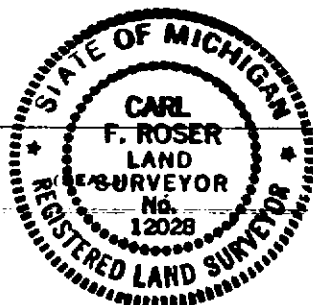

(SEAL)

SURVEYOR'S MICHIGAN REGISTRATION NO. _____

LIBERTY TOWNSHIP
WEXFORD COUNTY