

LAND CORNER RECORDATION CERTIFICATE

FILING REQUIREMENT OF ACT 74, MICH. P.A.1970

FOR CORNERS OF --:	LOCATED IN --:	CORNER CODE NUMBER
1. PUBLIC LAND SURVEY.....	T. 24 N. R. 9 W.	A-9; A-10; A-11
2. PROPERTY CONTROLLING IN SECTION 30.....	T. 24 N. R. 9 W.	8
3. MISCELLANEOUS PROPERTY IN SECTION.....	T. N. R. E. S. R. W.	
4. LOT NO....., RECORDED PLAT.....		
5. PRIVATE CLAIMS.....		

REGISTER OF DEEDS STAMP AND FILING NUMBER

I, Carl F. Roser, do hereby certify that under requirements of P.A. 74, Michigan P.A. of 1970 the corner points mentioned in lines 1 and 2 above were, in a field survey on May 6, 1980, established, re-established, monumented, re-monumented, recovered or restored as expressed below and in conformance with regulations and rules therefore as required in the current manual of survey instructions of the United States Department of the Interior Bureau of Land Management or by a decree of a court of law. Furthermore, that the corner points mentioned in lines 3, and 5 above were, in a field survey on _____, 19____, found, recovered, restored, established or re-established as expressed below and in conformance with the rules of the Michigan State Board of Registration for Land Surveyors or, by Decree of a Court of law:

~~A. - Description of original monument and accessories and/or subsequent restoration:~~

C. (continued)

8

Set 3/4"x7' pipe 1 1/2' above ground w/RLS Cap
 1/2" cedar post w/loc. tag
 6" Cedar S85°W 15.4
 4" Maple N10°W 12.9
 4" Cedar N73°E 5.2
 N-S woven wire fence
 West 18'±

B. Description of corner evidence found and/or method applied in restoring or re-establishing corner:

- A-9 Fd. bolt from Wexford Co. Rd. Comm. witnesses. Corner is in approximate intersection of E-W b'top road and N-S gravel road.
- A-10 Fd. & accepted rerod as set by RLS's G. Gray & D. Wood for W 1/4 corner S-30. Corner was set S.P. between fd. sec. corners 1/2 mile N & 1/2 mile S. Corner is in ctr. N-S gravel road & in line w/drainage ditch & fn. line on to west.
- A-11 Fd. & accepted well point for SW corner S-30. Corner used by RLS J. Wilcox in 1975 survey of Sec. 36, T24N-R10W.
- 8 Established W 1/8 corner on E-W 1/4 line, Sec. 30, at proportionate measure to U.S. (GLO) between W 1/4 corner & center of Sec. 30.

C. Description of monument for corner and accessories established to perpetuate locating the position of the corner:

A-9	A-10	A-11
Fd. nail over 3/4"x24" bolt, replaced w/Wex. Co. Mon.	Fd. 1/2"x18" rerod w/RLS Cap; repl. w/Wex. Co. Mon.	Fd. well pt.; replaced w/Wex. Co. Mon.
15" Twn. Maple N65°E 112.68	13" Elm stp. N30°W 27.09	Tele. Riser Pole
16" Cherry N60°W 87.63	12" Maple S35°E 49.42	N45°E 43.93
15" Cherry S10°E 102.12	5" Ash N75°E 29.27	Put loc. tag on riser pole
Set ced. post w/loc. tag	Set cedar post w/loc. tag	Cor. fn. post N45°W 37.39
S45°E 47'	East 33'	4" Apple S60°E 96.17
Power Pole S50°E 48.18		

SIGNED BY Carl F. Roser 7-23-80 DATE

SURVEYOR'S MICHIGAN REGISTRATION NO. 12028


FOR STATE AND UNITED STATES AGENCIES:

SIGNED BY _____ DATE _____

CHIEF OF SURVEY PARTY

APPROVED AND SIGNED BY _____ DATE _____

MICHIGAN REGISTERED LAND SURVEYOR

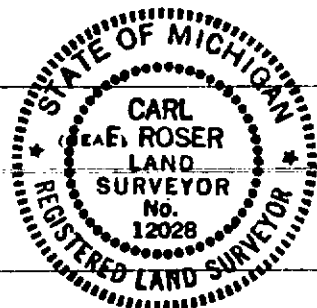

(SEAL)

SURVEYOR'S MICHIGAN REGISTRATION NO. _____

LIBERTY TOWNSHIP
WEXFORD COUNTY