LAND CORNER RECORDATION CERTIFICATE

Filing Requirement of Act 74, Mich. P.A. 1970

For corners in WEXFORD (County)

	Located In:		Corner Code ~~##~~
1. Public Land Survey	T 24N R 9W		A-5
	T ___ R ___		
	T ___ R ___		
	T ___ R ___		
2. Property Controlling	S 7 T ___ R ___		10
in Section	S ___ T ___ R ___		
3. Miscellaneous	S 7 T ___ R ___		654' E. OF
Property in Sec.	S ___ T ___ R ___		CODE 11

Register of Deeds Stamp & File Number

4. Lot No. _____ , Recorded Plat _____
5. Private Claims _____

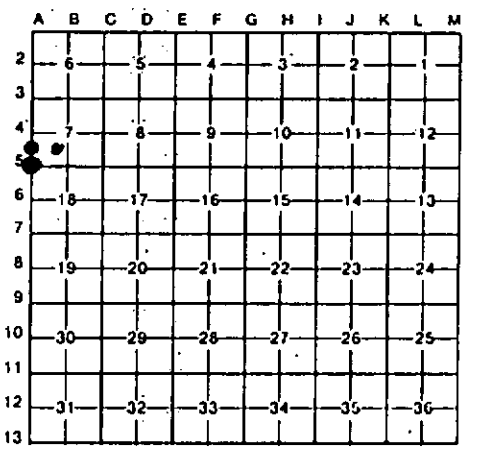

I, C.F.ROSER, in a field survey on NOV. 15, 19 91, do hereby certify that under requirements of P.A. 74, Michigan P.A. of 1970, the corner points mentioned in lines 1 and 2 above were in conformance with regulations and rules therefore as required in the current manual of survey instructions of the United States Department of the Interior, Bureau of Land Management or by a decree of a Court of Law and/or that the corner points mentioned in lines 3, 4 and 5 above were in conformance with the rules of the Michigan Board of Land Surveyors or by a Decree of a Court of Law; established, re-established, monumented, re-monumented, recovered, found as expressed below:

NOTE: Not more than 4 corners, all in the same town and range, may be recorded on this certificate.

A. Description of original monument and accessories and/or subsequent restoration:

A-5	10	654'E of11
FD 1/2" REROD W/LS CAP #21265 IN 1"O.D. PIPE. FD PIPE BURIED 21" IN CTR DIRT RDS E-W-S. PIPE FITS FD LARGE OLD ELM STUB, N4°E, 336.4'; (B.L.CAUKIN, FARGO ENGR, 1913 WIT: ELM 14, N4½°E, 336.8'). B.L.CAUKIN FD & ACCEPTED STONE IN 1913 THAT WAS "SAID TO BE GOVT CORNER".	ESTABLISHED SW COR OF NW1/4 OF SW1/4 OF SEC 7 PER STANDARD BLM INSTRUCTIONS. COR IS ON APPROXIMATE LINE OF OLD FN REMAINS ON GROUND TO S & E.	ESTABLISHED SE COR W1/2 OF NE1/4 OF SW1/4 SEC 7, PER STANDARD BLM INSTRUCTIONS. OLD N-S FN REMAINS, ON GROUND, & ROW OF OLD TREES LOOKING TO SOUTH, IS 48'±1' W. COR OF OLD FN REMAINS N-S-W IS 105'± 4' N & 48'± 5' W.

B. Description of corner evidence found and/or method applied in restoring or reestablishing corner:

C. Description of monument for corner and accessories established to perpetuate locating the position of the corner:

A-5			10			654'E of11		
FD 1/2" REROD W/LS CAP IN PIPE SE CORNER OF CONC BLK BLDG FND.	N55°W	79.5'	DROVE 5/8"x 34" REROD W/LS CAP & SET CEDAR POST W/LOC TAG. 6"TW.SUG.MAPLE	N55°W	10.0'	DROVE 5/8"x 34" REROD W/LS CAP & SET CEDAR POST W/LOC TAG. 12"APPLE	N03°W	96.92'
4"R.PINE	N35°E	79.17'	8"W.PINE	S75°E	45.7'	3"R.PINE	S75°W	60.85'
28"SUG.MAPLE	S70°E	75.73'	6"SUG.MAPLE	S15°E	5.2'	2"R.PINE	N65°W	78.41'
18" W.PINE	S60°W	49.27'	8"R.PINE	S60°W	21.9'			

STATE OF MICHIGAN
CARL F. ROSER
LAND SURVEYOR
No. 12028
REGISTERED LAND SURVEYOR

Signed by Carl F. Roser 01-09-92 Date _____

Surveyor's Michigan License No. 12028

FORM APPROVED BY MICHIGAN STATE BOARD OF LAND SURVEYORS, JAN. 28, 1971
REVISED MAY 14, 1975
REVISED JAN., 1983