LAND CORNER RECORDATION CERTIFICATE

Filing Requirement of Act 74, Mich. P.A. 1970

For corners in
MEXFORD
(County)

	Located In:	Corner Code 44
1. Public Land Survey	T 24N R 9W	C-3,C-4
	T ___ R ___	
	T ___ R ___	
	T ___ R ___	
2. Property Controlling	S 7 T ___ R ___	9
in Section	S ___ T ___ R ___	
3. Miscellaneous	S ___ T ___ R ___	
Property in Sec.	S ___ T ___ R ___	

Register of Deeds Stamp & File Number

4. Lot No. _____ , Recorded Plat _____
5. Private Claims _____

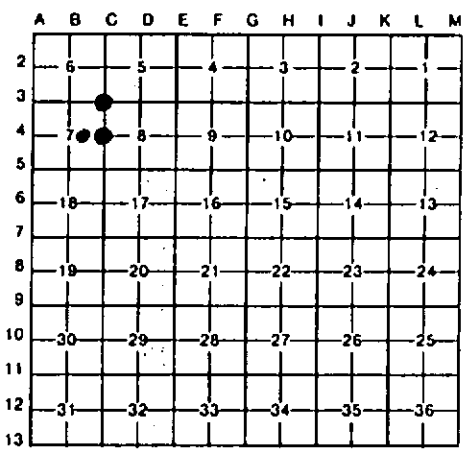

I, C.F.ROSER, in a field survey on NOV. 15, 19 91, do hereby certify that under requirements of P.A. 74, Michigan P.A. of 1970, the corner points mentioned in lines 1 and 2 above were in conformance with regulations and rules therefore as required in the current manual of survey instructions of the United States Department of the Interior, Bureau of Land Management or by a decree of a Court of Law and/or that the corner points mentioned in lines 3, 4 and 5 above were in conformance with the rules of the Michigan Board of Land Surveyors or by a Decree of a Court of Law; established, re-established, monumented, re-monumented, recovered, found as expressed below:

NOTE: Not more than 4 corners, all in the same town and range, may be recorded on this certificate.

A. Description of original monument and accessories and/or subsequent restoration:

C-3 C-4 9

B. Description of corner evidence found and/or method applied in restoring or reestablishing corner:

C-3
FD FARGO ENGR. 1913 1"(O.D.) PIPE MONUMENT LYING ON TOP OF GROUND. FD REMAINS OF FARGO WBT (CEDAR STP NW) AND DUG FOR FARGO BUTTER DISHES. FD 2 BUTTER DISHES (4" DEEP) AND DEFINITE RUSTY PIPE SHADOW FROM 9" DEEP TO 16" DEEP. PLACED DNR MON IN PIPE SHADOW. FARGO "RESURVEY LAND LINE MAP" SAY'S " FD BOTH U.S. WIT, CED. PLAINLY SCRIBED".

C-4
MONUMENTED E1/4 COR SEC 7 M.O.L. BETWN FD NE & SE COR'S SEC 7. B.L.CAUKIN (FARGO ENGR) DIDN'T FIND ANY U.S. EVIDENCE IN 1913 AND SET COR M.O.L. BTWN SEC CORS. COR FALLS ON STEEP CLAY BANK (VERY LITTLE VEGETATION). TOP OF CLAY BANK BLUFF (EDGE OF WOODS) IS 55'± ABOVE MON & 68' N. SWLY EDGE OF MANISTEE RV IS 30'± 2' E & 74'± 15' N.

9
ESTABLISHED NW COR OF NE1/4 OF SE1/4 SEC 7, PER STANDARD BLM INSTRUCTIONS. CTR 2' WIDE CREEK, COURSE N'LY, IN GULLY IS 36'± 3' W. OLD N-S FN IS 120' W.

C. Description of monument for corner and accessories established to perpetuate locating the position of the corner:

C-3
FD 3/4" PIPE & BUTTER DISHES; ADDED DNR MON & CEDAR POST.

11" CEDAR	N65°W	50.2'
8" CEDAR	N20°W	56.5'
8" CEDAR	N50°E	55.6'
8"TW.MAPLE	S70°E	26.0'
10" MAPLE	S55°W	15.2'

C-4
DROVE 1"x 59" GALV. PIPE WITH ALUM DNR CAP; SET CEDAR POST.

5"CEDAR	N80°E	27.5'
3"BALSAM	S05°E	13.9'
4"R.OAK	S10°W	22.3'

9
DROVE 5/8"x 34" REROD W/LS CAP & SET CEDAR POST W/LOC TAG.

7" MAPLE	N05°W	44.8'
8" MAPLE	N75°E	36.8'
11" MAPLE	S60°E	35.1'
7" CEDAR	S80°W	26.9'

STATE OF MICHIGAN
CARL F. ROSER
LAND SURVEYOR
No. 12028
REGISTERED LAND SURVEYOR

Signed by Carl F. Roser 01-09-92 Date _____

Surveyor's Michigan License No. 12028

FORM APPROVED BY MICHIGAN STATE BOARD OF LAND SURVEYORS, JAN. 28, 1971
REVISED MAY 14, 1975
REVISED JAN., 1983