LAND CORNER RECORDATION CERTIFICATE

Filing Requirement of Act 74, Mich. P.A. 1970

For corners in
MEXFORD
(County)

	Located In:	Corner Code ##
1. Public Land Survey	T 24N R 9W	C-5
	T ____ R ____	
	T ____ R ____	
	T ____ R ____	
2. Property Controlling	S 7 T ____ R ____	13,16
in Section	S ____ T ____ R ____	
3. Miscellaneous	S ____ T ____ R ____	
Property in Sec.	S ____ T ____ R ____	

Register of Deeds Stamp & File Number

4. Lot No. _____ , Recorded Plat _____
5. Private Claims _____

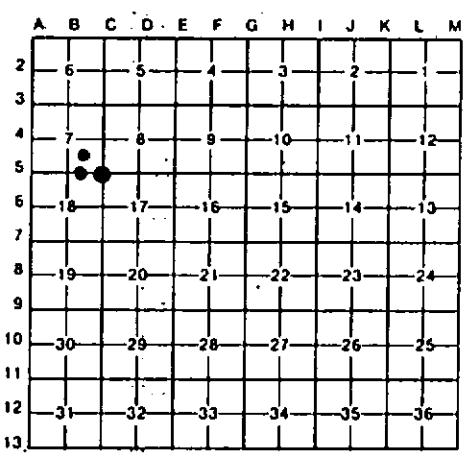

I, C.F.ROSER, in a field survey on NOV. 15, 19 91, do hereby certify that under requirements of P.A. 74, Michigan P.A. of 1970, the corner points mentioned in lines 1 and 2 above were in conformance with regulations and rules therefore as required in the current manual of survey instructions of the United States Department of the Interior, Bureau of Land Management or by a decree of a Court of Law and/or that the corner points mentioned in lines 3, 4 and 5 above were in conformance with the rules of the Michigan Board of Land Surveyors or by a Decree of a Court of Law; established, re-established, monumented, re-monumented, recovered, found as expressed below:

NOTE: Not more than 4 corners, all in the same town and range, may be recorded on this certificate.

A. Description of original monument and accessories and/or subsequent restoration:

C-5 13 16

B. Description of corner evidence found and/or method applied in restoring or reestablishing corner:

C-5
FD WEXFORD CO MON FOR SE COR SEC 7. MON IS ON WEST SIDE OF OLD 1" O.D. PIPE THAT WAS PROBABLY SET BY B.L.CAUKIN, FARGO ENGR, IN 1913. FD POSSIBLE REMAINS OF CAUKINS CEDAR BT SE. COR IS IN APPROX CTR OF GRAVEL RD LOOKING S & N.

13
ESTABLISHED SW COR OF NE1/4 OF SE1/4 OF SEC 7 PER STANDARD BLM INSTRUCTIONS. CTR N-S GRAVEL RD IS 28' W.

16
ESTABLISHED SE COR OF SW1/4 OF SE1/4 OF SEC 7 PER STANDARD BLM INSTRUCTIONS. CTR OF 21' WIDE E-W GRAVEL RD IS 8' N. CTR GRAVEL RD LOOKING TO N. IS 10' W.

C. Description of monument for corner and accessories established to perpetuate locating the position of the corner:

C-5
FD WEXFORD CO MONUMENT.

7" ELM	N25°W	5.54'
* 12"CEDAR	N05°E	42.00'
* 8" CEDAR	N60°E	28.10'
* 10"TW.CED	S30°E	35.51'
CTR. GRAVEL ROAD (IN CURVE)	S45°W	34'

13
DROVE 5/8"x 34" REROD W/LS CAP & SET CEDAR POST W/LOC TAG.

13" ASH	N70°E	19.4'
3" OAK	S20°E	31.2'
13" W.PINE	S55°W	77.5'

16
DROVE 5/8"x 34" REROD W/LS CAP.

2" CEDAR	N55°W	76.7'
8" R.PINE	N27°E	47.4'
8" CEDAR	S32°W	60.1'
4" MAPLE	S50°W	39.8'
SET CEDAR POST W/LOC TAG	SOUTH	33'

* = WIT BY OTHERS.

STATE OF MICHIGAN
CARL F. ROSER
LAND SURVEYOR
No. 12028
REGISTERED LAND SURVEYOR

Signed by Carl F. Roser 01-09-92 Date _____

Surveyor's Michigan License No. 12028

FORM APPROVED BY MICHIGAN STATE BOARD OF LAND SURVEYORS, JAN. 26, 1971
REVISED MAY 14, 1975
REVISED JAN., 1983