LAND CORNER RECORDATION CERTIFICATE

Filing Requirement of Act 74, Mich. P.A. 1970

For corners in
MEXFORD
(County)

Located In: Corner Code :11

1. Public Land Survey — T 24N R 9W — E-4, E-5
   T ____ R ____ — G-4
   T ____ R ____
   T ____ R ____
2. Property Controlling — S ____ T ____ R ____
   in Section — S ____ T ____ R ____
3. Miscellaneous — S ____ T ____ R ____
   Property in Sec. — S ____ T ____ R ____

Register of Deeds Stamp & File Number

4. Lot No. _____ , Recorded Plat _____
5. Private Claims _____

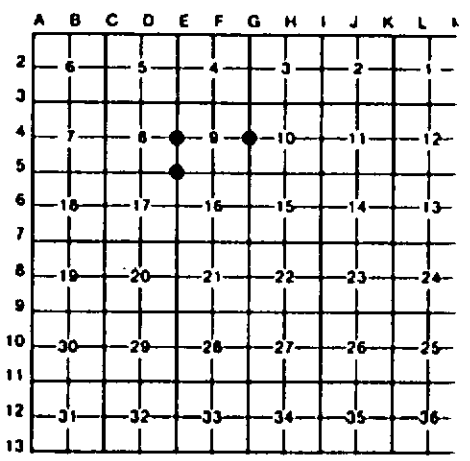

I, CARL F. ROSER, in a field survey on SEPTEMBER 1, _____, 19 93, do hereby certify that under requirements of P.A. 74, Michigan P.A. of 1970, the corner points mentioned in lines 1 and 2 above were in conformance with regulations and rules therefore as required in the current manual of survey instructions of the United States Department of the Interior, Bureau of Land Management or by a decree of a Court of Law and/or that the corner points mentioned in lines 3, 4 and 5 above were in conformance with the rules of the Michigan Board of Land Surveyors or by a Decree of a Court of Law; established, re-established, monumented, re-monumented, recovered, found as expressed below:

NOTE: Not more than 4 corners, all in the same town and range, may be recorded on this certificate.

A. Description of original monument and accessories and/or subsequent restoration:

E-4 E-5 G-4

(NO EVIDENCE OF G.L.O. CORNER, B.T'S, LINE TREES & TOPOGRAPHY, AS CALLED OUT IN THE G.L.O. LINE NOTES; UNLESS NOTED IN ITEM "B" BELOW.)

B. Description of corner evidence found and/or method applied in restoring or reestablishing corner:

E-4

FD 1" PIPE FOR W 1/4 COR S-9. PIPE FITS FOUR 1980 CONSUMER POWER CO. WITS & REMAINS OF ONE GLO WIT (CEDAR 30, N48°E 27 LKS- 17.8'). CTR OF OLD US-131 (NOW A SNOWMOBILE TRAIL) IS 183'± 5' WEST. W'LY EDGE OF MANISTEE RIVER IS 23'± EAST.

E-5

FD DEPT MON FOR SW COR S-9 AS SET IN 1971 DEPT SURVEY AT RECOV'D FARGO ENGR CORNER. MSHD ALSO RECOVERED AND WITNESSED FARGO PIPE IN ITS 1957 SURVEY. CTR N-S DIRT ROAD IS 205' WEST.

G-4

FD FARGO ENGR (1913) PIPE & BUTTER DISHES FOR E 1/4 COR OF S-9. COR FITS ONE FARGO ENGR WIT & 3 CONSUMER POWER CO. (1980) WITS. FARGO ENGR FOUND BOTH US WITS IN ITS 1913 SURVEY.

C. Description of monument for corner and accessories established to perpetuate locating the position of the corner:

E-4

FD 1" PIPE. ADDED DNR MON IN EXACT SAME POSITION. SET CED POST.

5" BALSAM	N75°W	4.5'
#18" CEDAR	N20°W	31.1'
#16" CEDAR	N50°E	15.3'
6" ASH	S70°E	7.6'

#CONS POWER CO 1980 WIT.

E-5

FD CONSERVATION DEPT. MON & CED POST.

4" MAPLE	N65°W	39.7'
10" W PINE	N65°E	8.1'
#13" W PINE	S20°E	14.3'
#16" W PINE	S75°W	64.1'

#1971 DNR WIT.

G-4

FD 3/4" X 30" GALV PIPE & 2 BUTTER DISHES. ADDED DNR MON IN EXACT SAME POSITION. SET CED POST.

# 7" CEDAR	N27°W	18.90'
9" W PINE	S30°E	48.50'
#18" HEMLOCK	S20°W	48.13'
# 5" W PINE	S25°W	15.44'

#CONS. POWER CO. 1980 WIT.

STATE OF MICHIGAN
CARL F. ROSER
LAND SURVEYOR
No. 12028
REGISTERED LAND SURVEYOR

Signed by Carl F. Roser Date 3-27-95

Surveyor's Michigan License No. 12028

FORM APPROVED BY MICHIGAN STATE BOARD OF LAND SURVEYORS, JAN 28, 1971
REVISED MAY 14, 1975
REVISED JAN , 1983