

1998 1 6 1998

SECTION

LAND CORNER RECORDATION CERTIFICATE  
Filing Requirement of Act 74, Mich. P.A. 1970

RECEIVED

1998 DEC 30 PM 2: 10

Linda Loughmiller  
WEXFORD COUNTY, MI  
REGISTER OF DEEDS

For corners in

\_\_\_\_\_ Located In: \_\_\_\_\_ Corner Code # \_\_\_\_\_  
 (County)

1. Public Land Survey T 24N R 10W M-2  
 T \_\_\_\_\_  
 T \_\_\_\_\_  
 T \_\_\_\_\_

2. Property Controlling S \_\_\_\_\_ T \_\_\_\_\_  
 in Section S \_\_\_\_\_ T \_\_\_\_\_  
 3. Miscellaneous S \_\_\_\_\_ T \_\_\_\_\_  
 Property in Sec. S \_\_\_\_\_ T \_\_\_\_\_

*Common to:  
 A-2 T24N, R9W*

Register of Deeds Stamp & File Number

4. Lot No. \_\_\_\_\_, Recorded Plat \_\_\_\_\_  
 5. Private Claims \_\_\_\_\_

A	B	C	D	E	F	G	H	I	J	K	L	M
1												
2	6		5		4		3		2		1	
3												
4	7		8		9		10		11		12	
5												
6	18		17		16		15		14		13	
7												
8	19		20		21		22		23		24	
9												
10	30		29		28		27		26		25	
11												
12	31		32		33		34		35		36	
13												

I, George D. Smith, P.S., in a field survey on April 16, 19 98 do hereby state that under requirements of P.A. 74, Michigan P.A. of 1970, the corner points mentioned in lines 1 and 2 above were in conformance with regulations and rules therefore as required in the current manual of survey instructions of the United States Department of the Interior, Bureau of Land Management or by a decree of a Court of Law and /or that the corner points mentioned in lines 3, 4 and 5 above were in conformance with the rules of the Michigan Board of Land Surveyors or by a Decree of a Court of Law; established, re-established, monumented, recovered, found as expressed below:

NOTE: Not more than 2 corners, all in the same town and range, may be recorded on this certificate.

A. Description of original monument and accessories and/or subsequent restoration:

- M-2) 1838 GLO Quarter Section Post by John Brink, Deputy Surveyor; Maple 7-N28W-22; Hemlock 9-S67W-36
- M-2) 1913 Fargo Engineering Co. Found stake and roots of 2 U.S. witnesses. Cedar stump N08W, 0.36', Cedar stump S72E, 11 1/2'.
- M-2) 1980 Roser, PS #12028 LCRC Liber 3, Page 231, found fargo butter dish and stake bottom shadow. Replaced fargo corner with Wexford County Monument. 10" cedar N66°W 20.3', 8" maple S23°W 15.7', 7" Maple N33°E 14.3', centerline north-south trail road east ± 97'
- M-2) 1985 Consumer Power Survey, Liber 2, Page 75 (copy not legible).

B. Description of corner evidence found and/or method applied in restoring or reestablishing corner:

- M-2) Found Wexford County Monument and one witness from 1980 Roser PS #12028 LCRC. This corner is accepted as a careful and faithful perpetuation of the position of the original corner, being the quarter corner common to Section 1, T24N, R10W and Section 6, T24N, R9W

C. Description of monument for corner and accessories established to perpetuate locating the position of the corner:


- M-2 Wexford Co. Monument with aluminum cap stamped E 1/4 1, 1998, PS 39098.
- N65W 20.72' 12" Cedar (20.3' Roser)
- S45W 14.29' 12" Hemlock
- N35E 14.66' 8" Maple
- East 6.75' 10" Cedar

Peer Group Reviewed and Approved

Date: 9 December 1998

Richard D. Wilcox  
Richard D. Wilcox, Wexford County Surveyor

Signed by \_\_\_\_\_  
Surveyor's Michigan License No. \_\_\_\_\_

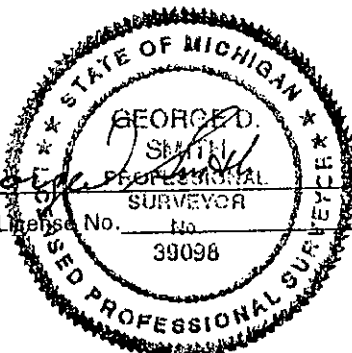

Date 12-9-98