

1998

RECEIVED

1998 DEC 30 PM 2: 10

SECTION

LAND CORNER RECORDATION CERTIFICATE
Filing Requirement of Act 74, Mich. P.A. 1970

Linda Loughmiller
WEXFORD COUNTY, MI
REGISTER OF DEEDS

For corners in

Wexford Located In: Corner Code #
(County)

1. Public Land Survey T 24N R 10W M-4

2. Property Controlling S _____ T _____
in Section S _____ T _____

3. Miscellaneous S _____ T _____
Property in Sec. S _____ T _____

4. Lot No. _____, Recorded Plat _____

5. Private Claims _____

Common to:

A-4

T24N, R9W ✓

Register of Deeds Stamp & File Number

A	B	C	D	E	F	G	H	I	J	K	L
1											
2	6		5		4		3		2		1
3											
4	7		8		9		10		11		12
5											
6	18		17		16		15		14		13
7											
8	19		20		21		22		23		24
9											
10	30		29		28		27		26		25
11											
12	31		32		33		34		35		36
13											

I, George D. Smith, P.S., in a field survey on April 16, 19 98 do hereby state that under requirements of P.A. 74, Michigan P.A. of 1970, the corner points mentioned in lines 1 and 2 above were in conformance with regulations and rules therefore as required in the current manual of survey instructions of the United States Department of the Interior, Bureau of Land Management or by a decree of a Court of Law and /or that the corner points mentioned in lines 3, 4 and 5 above were in conformance with the rules of the Michigan Board of Land Surveyors or by a Decree of a Court of Law; established, re-established, monumented, recovered, found as expressed below:

NOTE: Not more than 2 corners, all in the same town and range, may be recorded on this certificate.

A. Description of original monument and accessories and/or subsequent restoration:

- M-4) 1838 GLO Quarter Section Post by John Brink, Deputy Surveyor; Lynn 16 in dia quarter section corner.
- M-4) 1913 Fargo Survey no U.S. evidence. Set corner at proportional measure between. Found E 1/4 section 1 and found SE corner section 12. Sugar 16 N83 1/4 W 0.22, Cedar 14 N73 3/4 E 0.22.
- M-4) 1980 Roser, PS #12028 LCRC Liber 3, Page 230, found Fargo 1" pipe and 1 witness for 1/4 corner common to Sec. 12, T24N, R10W and Section 7, T24N, R9W. Replaced pipe with Wexford Co. Mon. 18" Twin cedar N85E 13.9, (Fargo Wit,) 21" Twin cedar S55W 17.2, 17" Cedar N40W 15.2.


B. Description of corner evidence found and/or method applied in restoring or reestablishing corner:

- M-4) Found Wexford County Monument and one witness from Roser LCRC and 1 witness from Fargo survey. This corner is accepted as a careful and faithful reestablishment of the position of the original corner being the quarter corner common to Sec. 12, T24N, R10W and Section 7, T24N, R9W.

C. Description of monument for corner and accessories established to perpetuate locating the position of the corner:

- M-4
Wexford Co. Monument stamped E 1/4 12 1998 PS 39098.
East 13.45' Tw. 16" Cedar, found nail (Fargo wit.)
S60W 18.70' Tw. 24" Cedar, found nail
N35E 15.88' 18" Cedar, found nail (Roser wit.)
S45E 42.84' 24" Maple with 12" Hemlock, found nail

Peer Group Reviewed and Approved
Date: 4 December 1998
Richard D. Wilcox
Richard D. Wilcox, Wexford County Surveyor

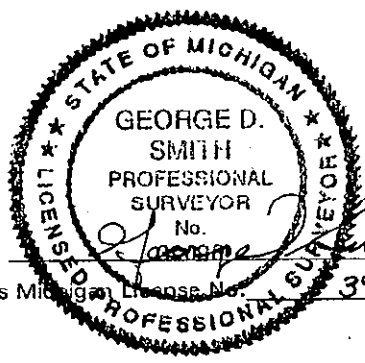

Signed by _____
Surveyor's Michigan License No. 39098

Date 12-9-98