

# SURVEY & REMONUMENTATION

APR 25 1995

RECEIVED

1994 DEC -9 PM 4: 24

## COMMISSIONED CORNER RECORDATION CERTIFICATE

Filing Requirement of Act 74, Mich. P.A. 1970

*Linda Loughmiller*  
WEXFORD COUNTY, MI  
REGISTER OF DEEDS

For corners in

Wexford <small>(County)</small>	Located In:	Corner Code #	
1. Public Land Survey	T <u>24N</u> R <u>9W</u>	<u>B-13</u>	
	T _____ R _____	_____	
	T _____ R _____	_____	
	T _____ R _____	_____	
2. Property Controlling in Section	S _____ T _____ R _____	_____	
	S _____ T _____ R _____	_____	
3. Miscellaneous Property in Sec.	S _____ T _____ R _____	_____	
	S _____ T _____ R _____	_____	
4. Lot No. _____, Recorded Plat _____			
5. Private Claims _____			

Register of Deeds Stamp & File Number

I, George D. Smith, in a field survey on August 11, 1994, do hereby certify that under requirements of P.A. 74, Michigan P.A. of 1970, the corner points mentioned in lines 1 and 2 above were in conformance with regulations and rules therefore as required in the current manual of survey instructions of the United States Department of the Interior, Bureau of Land Management or by a decree of a Court of Law and/or that the corner points mentioned in lines 3, 4 and 5 above were in conformance with the rules of the Michigan Board of Land Surveyors or by a Decree of a Court of Law; established, re-established, monumented, re-monumented, recovered, found as expressed below:

	A	B	C	D	E	F	G	H	I	J	K	L	M
2	6	5	4	3	2	1							
3													
4	7	8	9	10	11	12							
5													
6	18	17	16	15	14	13							
7													
8	19	20	21	22	23	24							
9													
10	30	29	28	27	26	25							
11													
12	31	32	33	34	35	36							
13													

**NOTE: Not more than 4 corners, all in the same town and range, may be recorded on this certificate.**

- A. Description of original monument and accessories and/or subsequent restoration:
- B-13) 1838 GLO Quarter Section post by John Brink, Deputy Surveyor, Elm 10 N 21° E 39, Sugar 18 N 17° W 20
  - B-13) 1979 Wilcox Certificate of Survey, Liber 1, page 723, Found wagonskein, set Wexford County monument, S 50° E 6" Red Pine 81.38', N 45° E 8" Jack Pine 84.65', N 5° E corner fence post 41.57', S 5°W tele riser 37.76'
  - B-13) 1979 Wilcox LCRC, Liber 03, page 723, Found wagonskein opposite fence line North and South, set Wexford County monument
  - B-13) 1979 Wilcox Certificate of Survey, Liber 1, page 767, Wexford County monument
  - B-13) 1989 Wilcox LCRC, Liber 04, page 15, Found Wexford County monument, S 12° E 55.46' 12" Red Pine, S 40° E 72.39' 14" Red Pine, N 04° W 41.55' fence corner, N 29°E 68.89' 14" Red Pine
  - B-13) 1989 Wilcox Certificate of Survey, Liber 69, page 341-342, Found Wexford County monument
- B. Description of corner evidence found and/or method applied in restoring or reestablishing corner:

A. con't

- B-13) 1994 Wilcox Certificate of Survey, Liber 73, page 412-413, Found Wexford County monument, S 12° E 55.46' 12" Red Pine, S 40° E 72.39' 14" Red Pine, N 4° W 41.55' fence corner, N 29°E 68.89' 14" Red Pine

B.

Found Wexford County monument with aluminum cap ±1.5' South of centerline road East-West and in line with fences North-South. This corner is accepted as a careful and faithful perpetuation of the position of the original corner, being the 1/4 corner common to Section 31, T24N, R9W and Section 6, T23N, R9W.


- C. Description of monument for corner and accessories established to perpetuate locating the position of the corner:

Wexford County monument with aluminum cap ±1.5' South of centerline East-West road and at intersection of fence lines North-South

- S 40° E - 72.39' - 14" Red Pine
- N 2° E - 41.66' - Fence corner
- N 32° E - 68.87' - 14" Red Pine
- S 12° E - 55.46' - 12" Red Pine

LIBER **004** PAGE **319**

Signed by *George D. Smith*  
Surveyor's Michigan License No. 39098

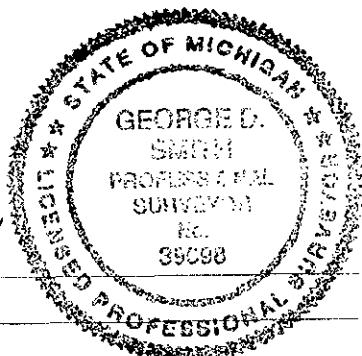

Peer Group Reviewed and Approved

Date: 12-9-94  
*Richard D. Wilcox*  
Richard D. Wilcox, Wexford County Surveyor

Date 11/17/94