

SURVEY & REMONUMENTATION

APR 25 1995

COMMISSION

LAND CORNER RECORDATION CERTIFICATE

Filing Requirement of Act 74, Mich. P.A. 1970

For corners in

<u>Wexford</u> <small>(County)</small>	Located In:	Corner Code #	
1. Public Land Survey	T <u>24N</u> R <u>9W</u>	<u>C-13</u>	
	T _____ R _____	_____	_____
	T _____ R _____	_____	_____
	T _____ R _____	_____	_____
2. Property Controlling in Section	S _____ T _____ R _____	_____	_____
	S _____ T _____ R _____	_____	_____
3. Miscellaneous Property in Sec.	S _____ T _____ R _____	_____	_____
	S _____ T _____ R _____	_____	_____

State of Michigan
County of Wexford
Recorded 9th day of Dec
19 94 A.D. at 4:24 o'clock P M
Linda Loughmiller
Register of Deeds

Register of Deeds Stamp & File Number

4. Lot No. _____, Recorded Plat _____
5. Private Claims _____

	A	B	C	D	E	F	G	H	I	J	K	L	M
2	6	5	4	3	2	1							
3													
4	7	8	9	10	11	12							
5													
6	18	17	16	15	14	13							
7													
8	19	20	21	22	23	24							
9													
10	30	29	28	27	26	25							
11													
12	31	32	33	34	35	36							
13													

I, George D. Smith, in a field survey on August 11, 19 94, do hereby certify that under requirements of P.A. 74, Michigan P.A. of 1970, the corner points mentioned in lines 1 and 2 above were in conformance with regulations and rules therefore as required in the current manual of survey instructions of the United States Department of the Interior, Bureau of Land Management or by a decree of a Court of Law and/or that the corner points mentioned in lines 3, 4 and 5 above were in conformance with the rules of the Michigan Board of Land Surveyors or by a Decree of a Court of Law, established, re-established, monumented, re-monumented, recovered, found as expressed below:

NOTE: Not more than 4 corners, all in the same town and range, may be recorded on this certificate.

- A. Description of original monument and accessories and/or subsequent restoration:
- C-13) 1838 GLO Section post by John Brink, Deputy Surveyor, Beech 9 N 50° E 26, Lynn 10 N 8° W 31
 - C-13) 1852 GLO subdivision of Section 5 & 6, T23N, R9W by V.W. Calkins, Deputy Survey, Found post, Beech 9° S 44° E 12, Sugar 16" S 20° W 32
 - C-13) 1896 A.J. Teed, Liber 1, page 242, survey in Section 5, T23N, R9W, corner found (no description given) Sugar 8 S 36 1/2° E 56 links
 - C-13) 1899 Teed survey, Liber 1, page 334, Found iron, no witnesses given
 - C-13) Wexford County Road Commission witnesses (no date given), Found gas pipe 12" Maple S 48° E 37.00', F.P. N 41° W 46.00 (old witness book)
 - C-13) 1973 Wilcox LCRC, Liber 2, page 542, Found 1 1/2" pipe in centerline of North-South and east-West roads, replaced with Wexford County monument, N 45° E 53.16' 12" Maple, S 45° E 44.43' fence corner, N 70° W 73.85' power pole

B. Description of corner evidence found and/or method applied in restoring or reestablishing corner:

A. con't

- C-13) 1973 Wilcox Certificate of Survey, Liber 1, page 106, Set Wexford County monument
- C-13) 1976 Wilcox Certificate of Survey, Liber 1, page 408, Found Wexford County monument
- C-13) 1977 Wilcox Certificate of Survey, Liber 1, page 493, Found Wexford County monument, N 45° E 53.16' 12" Maple
- C-13) 1979 Wilcox Certificate of Survey, Liber 1, page 723 and 767, Found Wexford County monument
- C-13) 1989 Wilcox LCRC, Liber 4, page 15, Found Wexford County monument, N 70° W 73.85' power pole, N 45° E 53.16' 14" Maple, N 78° E 81.03' 14" Cherry, S 56° W 86.70' fence post
- C-13) 1989 Wilcox Certificate of Survey, Liber 69, page 341-342, Found Wexford County monument

B.


Found Wexford County monument with aluminum cap in centerline road East-West-North and 1' West centerline South. This corner is accepted as a careful and faithful perpetuation of the position of the original corner, being the Section corner common to Sections 31 and 32, T24N, R9W and Sections 5 and 6, T23N, R9W.

C. Description of monument for corner and accessories established to perpetuate locating the position of the corner:

Wexford County monument with aluminum cap in centerline road East-West-North and 1' West centerline South

- N 70° W - 73.85' - Power pole
- N 45° E - 53.16' - 14" Maple
- N 78° E - 80.99' - 14" Cherry
- N 35° E - 80.62' - 16" Maple
- S 13° E - 110.62' - Center of 2" steel light pole on East side, in 9" x 9" brick pillar

LIBER **004** PAGE **330**

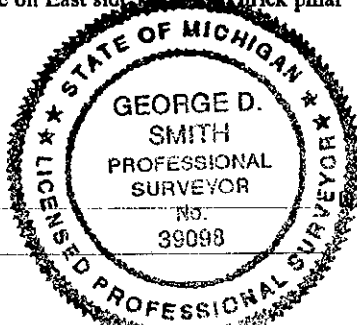

Peer Group Reviewed and Approved
Date: 12-2-94
Richard D. Wilcox
Richard D. Wilcox, Wexford County Surveyor

Signed by *George D. Smith*
Surveyor's Michigan License No. 39098

Date 11/17/94