

# SURVEY & REMONUMENTATION

APR 25 1995

COMMISSION

## LAND CORNER RECORDATION CERTIFICATE Filing Requirement of Act 74, Mich. P.A. 1970

RECEIVED

1994 DEC -9 PM 4:24

*Linda Loughmiller*  
WEXFORD COUNTY, MI  
REGISTER OF DEEDS

For corners in

Wexford  
(County)

Located In:

Corner Code #

- |                                       |                          |  |  |      |
|---------------------------------------|--------------------------|--|--|------|
| 1. Public Land Survey                 | T <u>24N</u> R <u>9W</u> |  |  | E-13 |
|                                       | T _____ R _____          |  |  |      |
|                                       | T _____ R _____          |  |  |      |
|                                       | T _____ R _____          |  |  |      |
| 2. Property Controlling in Section    | S _____ T _____ R _____  |  |  |      |
|                                       | S _____ T _____ R _____  |  |  |      |
| 3. Miscellaneous Property in Sec.     | S _____ T _____ R _____  |  |  |      |
|                                       | S _____ T _____ R _____  |  |  |      |
| 4. Lot No. _____, Recorded Plat _____ |                          |  |  |      |
| 5. Private Claims _____               |                          |  |  |      |

Register of Deeds Stamp & File Number


	A	B	C	D	E	F	G	H	I	J	K	L	M
2	6	5	4	3	2	1							
3													
4	7	8	9	10	11	12							
5													
6	18	17	16	15	14	13							
7													
8	19	20	21	22	23	24							
9													
10	30	29	28	27	26	25							
11													
12	31	32	33	34	35	36							
13													

I, George D. Smith, in a field survey on August 11, 1994, do hereby certify that under requirements of P.A. 74, Michigan P.A. of 1970, the corner points mentioned in lines 1 and 2 above were in conformance with regulations and rules therefore as required in the current manual of survey instructions of the United States Department of the Interior, Bureau of Land Management or by a decree of a Court of Law and/or that the corner points mentioned in lines 3, 4 and 5 above were in conformance with the rules of the Michigan Board of Land Surveyors or by a Decree of a Court of Law, established, re-established, monumented, re-monumented, recovered, found as expressed below:

**NOTE: Not more than 4 corners, all in the same town and range, may be recorded on this certificate.**

- A. Description of original monument and accessories and/or subsequent restoration:
- E-13) 1838 GLO Section post by John Brink, Deputy Surveyor, Beech 9" N 50° E 26, Lynn 10" N 8° W 31
  - E-13) 1852 GLO subdivision of Section 4 & 5, T23N, R9W, by V.W. Calkins, Deputy Surveyor, Cedar 18" S 32° E 34, Cedar 12" S 20° W 29
  - E-13) 1895 A.J. Teed Survey in Section 4, T23N, R9W, Liber 1, page 239, corner found (no description given) H. Pine 20" S 49 3/4° W 67 1/2 links
  - E-13) 1896 A.J. Teed Survey in Section 5, T23N, R9W, Liber 1, page 242, corner found (no description or witnesses given)
  - E-13) 1899 Alderman Survey, Liber 1, page 334, Found stake (no witnesses given)
  - E-13) Wexford County Road Commission witnesses (no description or date given) corner fence post Northwest 37.03', corner fence post Southwest 44.30' (old witness book)
- B. Description of corner evidence found and/or method applied in restoring or reestablishing corner:
- A. con't
- E-13) 1972 Wilcox LCRC, Liber 1, page 99, Found iron in road intersection, fence post S 60° E 64.64', corner fence post S 25° W 44.30', corner fence post N 35° W 37.03'
  - E-13) 1973 Wilcox LCRC, Liber 2, page 560, Found 1/2" iron, replaced with Wexford County monument, N 60° E 60.31' power pole, N 45° W 48.30' fence corner, S 45° W 42.35' power pole
  - E-13) 1977 Wilcox Certificate of Survey, Liber 1, page 546, Found Wexford County monument
  - E-13) 1978 Wilcox Certificate of Survey, Liber 2, page 357, Found Wexford County monument, S 46° W corner fence post 51.20', N 36° W corner fence post 48.68', N 44° E 4" Spruce 78.00', S 17° E North side of yield sign 46.36'
  - E-13) 1987 Wilcox Certificate of Survey, Liber 66, page 532, Found Wexford County monument
- B.  
Found Wexford County monument with top broken 14' North of centerline East-West and 16' West of centerline North-South. Corner is accepted as a careful and faithful perpetuation of the position of the original corner, being the Section corner common Sections 32 and 33, T24N, R9W and Sections 5 and 4, T23N, R9W.
- C. Description of monument for corner and accessories established to perpetuate locating the position of the corner:

- Set 5/8" x 36" Iron with Wexford County brass cap stamped SE 32 1994 PS 33989
- S 47° E 64.84' - 4" x 4" sign post
- N 44° E - 78.14' - 8" Spruce
- N 38° W - 48.73' - Corner fence post
- S 40° W - 42.35' - Power pole

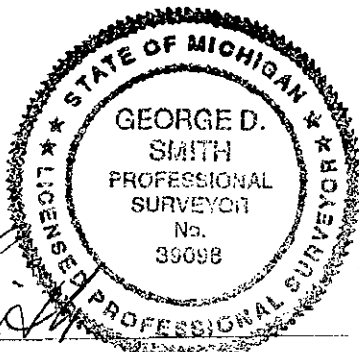

Peer Group Reviewed and Approved

Date: 12-2-94  
*Richard D. Wilcox*  
Richard D. Wilcox, Wexford County Surveyor

LIGER 004 PAGE 326

Signed by George D. Smith  
Surveyor's Michigan License No. 39098

Date 11/29/94