

SURVEY & REMONUMENTATION

APR 25 1995

COMMISSION

RECEIVED

LAND CORNER RECORDATION CERTIFICATE
 Filing Requirement of Act 74, Mich. P.A. 1970

1994 DEC -9 PM 4: 24

For corners in

Wexford
 (County)

Located In:

Corner Code #

- | | | |
|---------------------------------------|--------------------------|-------------|
| 1. Public Land Survey | T <u>24N</u> R <u>9W</u> | <u>H-13</u> |
| | T _____ R _____ | _____ |
| | T _____ R _____ | _____ |
| | T _____ R _____ | _____ |
| 2. Property Controlling in Section | S _____ T _____ R _____ | _____ |
| | S _____ T _____ R _____ | _____ |
| 3. Miscellaneous Property in Sec. | S _____ T _____ R _____ | _____ |
| | S _____ T _____ R _____ | _____ |
| 4. Lot No. _____, Recorded Plat _____ | | |
| 5. Private Claims _____ | | |

Linda Loughmiller
 WEXFORD COUNTY, MI
 REGISTER OF DEEDS

Register of Deeds Stamp & File Number

I, George D. Smith, in a field survey on November 3, 1994, do hereby certify that under requirements of P.A. 74, Michigan P.A. of 1970, the corner points mentioned in lines 1 and 2 above were in conformance with regulations and rules therefore as required in the current manual of survey instructions of the United States Department of the Interior, Bureau of Land Management or by a decree of a Court of Law and/or that the corner points mentioned in lines 3, 4 and 5 above were in conformance with the rules of the Michigan Board of Land Surveyors or by a Decree of a Court of Law; established, re-established, monumented, re-monumented, recovered, found as expressed below:

A	B	C	D	E	F	G	H	I	J	K	L	M
2	6	5	4	3	2	1						
3												
4	7	8	9	10	11	12						
5												
6	18	17	16	15	14	13						
7												
8	19	20	21	22	23	24						
9												
10	30	29	28	27	26	25						
11												
12	31	32	33	34	35	36						
13												

NOTE: Not more than 4 corners, all in the same town and range, may be recorded on this certificate.

A. Description of original monument and accessories and/or subsequent restoration:

- H-13) 1838 GLO Quarter Section post by John Brink, Deputy Surveyor, Hemlock 18" 1/4 Section corner
- H-13) 1962 Norton & Kobbins survey (not recorded), Found 1/2" Iron, no witnesses given
- H-13) 1969 Wilcox survey (not recorded), Found 1/2" pipe in monument box, 26" Maple 100.00' N 75° W, 18" Tri-Maple 66.17' N 45° W
- H-13) 1970 Wilcox Certificate of Survey, Liber 248, page 921, Found Iron, no witnesses given
- H-13) 1977 Wilcox Certificate of Survey, Liber 1, page 531, Found 1/2" pipe in monument box
- H-13) 1978 Wilcox Certificate of Survey, Liber 1, page 702, Found 3/4" Iron bar in monument box, N 35° W 8" Tri-Maple 66.30', N 45° E 5" Maple 30.56', East utility pole 31.09', S 45° E fence post 50.50'
- H-13) 1978 Wilcox Certificate of Survey, Liber 1, page 625, Found 1/2" Iron in monument box

B. Description of corner evidence found and/or method applied in restoring or reestablishing corner:

A. con't.

- H-13) 1978 Wilcox LCRC, Liber 3, page 201, Found 3/4" Iron in monument box, N 35°W 8" Tri-Maple, N 45° E 5" Maple 30.56' East utility pole 31.09', S 45° E fence post 50.50'
- H-13) 1979 Wilcox LCRC, Liber 3, page 218, Found 3/4" Iron, East power pole 31.09', N 35° W 8" Tri-Maple 66.30', N 45° E 5" Maple 30.56', S 45° E fence post 50.50'
- H-13) 1979 Wilcox Certificate of Survey, Liber 1, page 775, Found 3/4" Iron
- H-13) 1981 Wilcox Certificate of Survey, Liber 1, page 905, Found 3/4" Iron
- H-13) 1981 Wilcox Certificate of Survey, Liber 1, page 909, Found 3/4" Iron


B.

Found 1/2" pipe in monument box ±3.5' East of centerline of North-South road. This corner is accepted as a careful and faithful perpetuation of the position of the original corner, being the 1/4 corner common to Section 34, T24N, R9W and Section 3, T23N, R9W.

C. Description of monument for corner and accessories established to perpetuate locating the position of the corner:

Set 5/8" x 36" Iron with Wexford County brass cap stamped S 1/4 34, 1994 PS 33989, in monument box

- N 45° E - 30.63' - 6" Maple
- N 70° E - 34.43' - Twin 14" Maple
- East - 61.85' - 40" Maple
- N 85° E - 30.04' - 8" Maple
- N 31° W - 65.85' - Tri 9" Maple

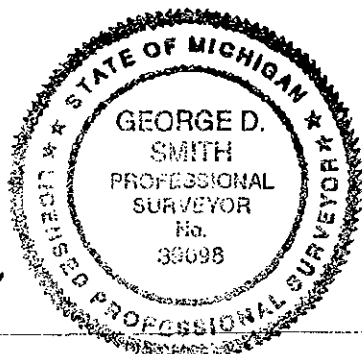

Peer Group Reviewed and Approved

Date: 12-2-94
Richard D. Wilcox
 Richard D. Wilcox, Wexford County Surveyor

LIBER **004** PAGE **329**

Signed by *George D. Smith*
 Surveyor's Michigan License No. 39098

Date 11/29/94