

SURVEY & REMONUMENTATION

APR 25 1995

COMMISSION

RECEIVED

1994 DEC -9 PM 4: 24

LAND CORNER RECORDATION CERTIFICATE Filing Requirement of Act 74, Mich. P.A. 1970

For corners in

Wexford
(County)

Located in:

Corner Code #

- | | | |
|---------------------------------------|--------------------------|-------------|
| 1. Public Land Survey | T <u>24N</u> R <u>9W</u> | <u>I-13</u> |
| | T _____ R _____ | _____ |
| | T _____ R _____ | _____ |
| | T _____ R _____ | _____ |
| 2. Property Controlling
in Section | S _____ T _____ R _____ | _____ |
| | S _____ T _____ R _____ | _____ |
| 3. Miscellaneous
Property in Sec. | S _____ T _____ R _____ | _____ |
| | S _____ T _____ R _____ | _____ |
| 4. Lot No. _____, Recorded Plat _____ | | |
| 5. Private Claims _____ | | |

Linda Loughmiller
WEXFORD COUNTY, MI
REGISTER OF DEEDS

Register of Deeds Stamp & File Number

I, George D. Smith, in a field survey on November 3, 19 94, do hereby certify that under requirements of P.A. 74, Michigan P.A. of 1970, the corner points mentioned in lines 1 and 2 above were in conformance with regulations and rules therefore as required in the current manual of survey instructions of the United States Department of the Interior, Bureau of Land Management or by a decree of a Court of Law and/or that the corner points mentioned in lines 3, 4 and 5 above were in conformance with the rules of the Michigan Board of Land Surveyors or by a Decree of a Court of Law; established, re-established, monumented, re-monumented, recovered, found as expressed below:

	A	B	C	D	E	F	G	H	I	J	K	L	M
2	6	5	4	3	2	1							
3													
4	7	8	9	10	11	12							
5													
6	18	17	16	15	14	13							
7													
8	19	20	21	22	23	24							
9													
10	30	29	28	27	26	25							
11													
12	31	32	33	34	35	36							
13													

NOTE: Not more than 4 corners, all in the same town and range, may be recorded on this certificate.

A. Description of original monument and accessories and/or subsequent restoration:

- I-13) 1838 GLO Section post by John Brink, Deputy Surveyor, Sugar 10 N 14° W 36, Sugar 12 N 15° E 47
- I-13) 1852 GLO subdivision of Section 2 and 3, T23N, R9W by V.W. Caukins, Deputy Surveyor, Found post, Sugar 18 S 66° E 12, Sugar S 42° W 49
- I-13) 1899 Alderman, Liber 1, page 337, Found stake and 1 government witness (no witnesses given)
- I-13) Wexford County Road Commission (no date or witnesses given), Found axle shaft
- I-13) 1978 Wilcox LCRC, Liber 3, page 201, Found axle shaft S 75° W 10" Basswood 30.90, N 05° E 2" Maple 3.48, N 75° E 6" Maple 23.04, S 30° W 4" Basswood 17.69
- I-13) 1978 Wilcox Certificate of Survey, Liber 1, page 702, Found axle shaft

B. Description of corner evidence found and/or method applied in restoring or reestablishing corner:

Found axle shaft ± in centerline roads East and South. This corner is accepted as a careful and faithful perpetuation of the position of the original corner, being the Section corner common to Sections 34 and 35, T24N, R9W and Sections 2 and 3, T23N, R9W.

Peer Group Reviewed and Approved


Date: 12-9-94
Richard D. Wilcox
Richard D. Wilcox, Wexford County Surveyor

C. Description of monument for corner and accessories established to perpetuate locating the position of the corner:

Axle shaft, stamped SE 34 1994, PS 39098

- S 38° W - 43.20' - 8" Basswood
- S 77° W - 30.99' - Tri 9" Maple
- S 45° E - 53.42' - 8" Maple (in clump)
- N 82° E - 67.68' - 4" Maple (in clump)

LIBER **004** PAGE **318**

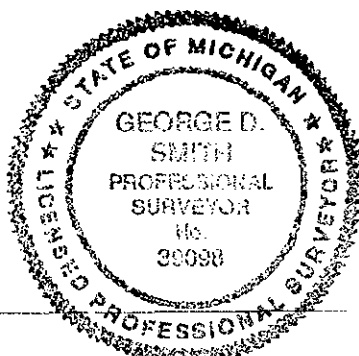

Signed by *George D. Smith*
Surveyor's Michigan License No. 39098

Date 11/29/94