

**SURVEY &  
REMONUMENTATION**

APR 25 1995

COMMISSION

RECEIVED

1994 DEC 12 AM 10:00

**LAND CORNER RECORDATION CERTIFICATE**  
Filing Requirement of Act 74, Mich. P.A. 1970

For corners in

<u>Wexford</u> <small>(County)</small>	Located In:	Corner Code #
1. Public Land Survey	T <u>24N</u> R <u>9W</u>	<u>J-13</u>
	T _____ R _____	_____
	T _____ R _____	_____
	T _____ R _____	_____
2. Property Controlling in Section	S _____ T _____ R _____	_____
	S _____ T _____ R _____	_____
3. Miscellaneous Property in Sec.	S _____ T _____ R _____	_____
	S _____ T _____ R _____	_____
4. Lot No. _____, Recorded Plat _____		
5. Private Claims _____		

*Linda Loughmiller*  
WEXFORD COUNTY, MI  
REGISTER OF DEEDS

Register of Deeds Stamp & File Number

I, George D. Smith, in a field survey on November 3, 19 94, do hereby certify that under requirements of P.A. 74, Michigan P.A. of 1970, the corner points mentioned in lines 1 and 2 above were in conformance with regulations and rules therefore as required in the current manual of survey instructions of the United States Department of the Interior, Bureau of Land Management or by a decree of a Court of Law and/or that the corner points mentioned in lines 3, 4 and 5 above were in conformance with the rules of the Michigan Board of Land Surveyors or by a Decree of a Court of Law, established, re-established, monumented, re-monumented, recovered, found as expressed below:

	A	B	C	D	E	F	G	H	I	J	K	L	M
2	6	5	4	3	2	1							
3													
4	7	8	9	10	11	12							
5													
6	18	17	16	15	14	13							
7													
8	19	20	21	22	23	24							
9													
10	30	29	28	27	26	25							
11													
12	31	32	33	34	35	36							
13													

**NOTE: Not more than 4 corners, all in the same town and range, may be recorded on this certificate.**

A. Description of original monument and accessories and/or subsequent restoration:

- J-13) 1838 GLO 1/4 section post by John Brink, Deputy Surveyor, 12" Beech 1/4 section corner
- J-13) 1899 Alderman survey Liber 1, page 337. Stake - no witnesses given
- J-13) 1992 Mitchell & Associates, Survey in Section 35, (not recorded) set 1/2 iron and cap, corner fence post, South 33.00', 24" Maple, S 54° E 45.47' 9" Scotch Pine N 55° E 75.78', 4" Cherry S 49° W 39.35', position fits Aldermans Survey to North and fence line to South

B. Description of corner evidence found and/or method applied in restoring or reestablishing corner:


Found 1/2 iron and cap #28917 and #30079 in centerline of road, East-West and opposite fence line South. Corner is accepted as a careful and faithful reestablishment of the position of the original corner being the 1/4 corner common to Section 35, T24N, R9W and Section 2, T23N, R9W

Peer Group Reviewed and Approved

Date: 12-9-94  
*Richard D. Wilcox*  
Richard D. Wilcox, Wexford County Surveyor

C. Description of monument for corner and accessories established to perpetuate locating the position of the corner:

Set 5/8" x 36" iron with Wexford County Brass cap, stamped S 1/4 35, 1994 PS #39098 (in place of 1/2 iron and cap) in centerline of road East-West, and 13' West of centerline road to North and opposite fence line to South  
 S 5° W - 33.00' - Fence post  
 S 49° W - 39.32' - 4" Cherry  
 N 55° E - 75.75' - 10" Scotch Pine  
 S 54° E - 45.53' - 40" Maple

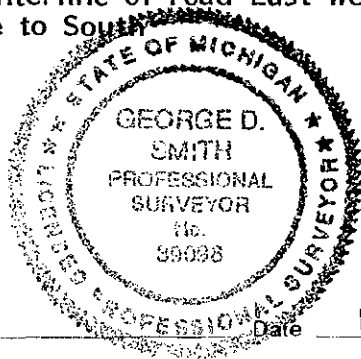

LIBER 04 PAGE 332

Signed by *George D. Smith*  
39098

December 9, 1994

Surveyor's Michigan License No. \_\_\_\_\_