

RECEIVED

1998 DEC 30 PM 2:11

Linda Loughmiller  
WEXFORD COUNTY, MI  
REGISTER OF DEEDS

LAND CORNER RECORDATION CERTIFICATE  
Filing Requirement of Act 74, Mich. P.A. 1970

SECTION

For corners in

Wexford (County)	Located In:	Corner Code #
1. Public Land Survey	T <u>24N</u> R <u>09W</u>	<u>M-2</u>
	T _____ R _____	_____
	T _____ R _____	_____
	T _____ R _____	_____
2. Property Controlling in Section	S _____ T _____ R _____	_____
	S _____ T _____ R _____	_____
3. Miscellaneous Property in Sec.	S _____ T _____ R _____	_____
	S _____ T _____ R _____	_____

Register of Deeds Stamp & File Number

4. Lot No. \_\_\_\_\_, Recorded Plat \_\_\_\_\_  
5. Private Claims \_\_\_\_\_

	A	B	C	D	E	F	G	H	I	J	K	L	M
1													
2		6		5		4		3		2		1	
3													
4		7		8		9		10		11		12	
5													
6		18		17		16		15		14		13	
7													
8		19		20		21		22		23		24	
9													
10		30		29		28		27		26		25	
11													
12		31		32		33		34		35		36	
13													

I, George D. Smith, P.S., in a field survey on May 18, 19 98 do hereby state that under requirements of P.A. 74, Michigan P.A. of 1970, the corner points mentioned in lines 1 and 2 above were in conformance with regulations and rules therefore as required in the current manual of survey instructions of the United States Department of the Interior, Bureau of Land Management or by a decree of a Court of Law and /or that the corner points mentioned in lines 3, 4 and 5 above were in conformance with the rules of the Michigan Board of Land Surveyors or by a Decree of a Court of Law; established, re-established, monumented, recovered, found as expressed below:

NOTE: Not more than 2 corners, all in the same town and range, may be recorded on this certificate.

A. Description of original monument and accessories and/or subsequent restoration:

- M-2) 1838 GLO Quarter Section Post by John Brink, Deputy Surveyor. Beech 8-S64W-10; Beech 10-N53½W-66.
- M-2) 1913 Fargo Engineering Co. found stone said to have been perp't from U.S. Witnesses. Accepted position of stone, white pine stump 20-S76E- 0.68; White Pine stump 30-N26W-0.11.
- M-2) 1983 Mitchell PS #28417 LCRC Liber 3, Page 342. Found 1" iron pipe and butter dishes by Fargo, added Wexford County Monument. N75E 20" Y.P.S. 28.08; S50°W 6" Red Pine 70.45"; S85W 28" Maple 169.95"; N20W 3" Balsam Fir 8.0', S80E 10" White Birch 11.3'.
- M-2) 1989 Schripsema PS 24617 Cert. of Survey, Liber S-2, Page 537. Miss. Co. Records found Wexford Co. Mon. N75E 28.08' 20" YPS, East 34.25' Fence post, S50W 70.45 6" R. Pine.

B. Description of corner evidence found and/or method applied in restoring or reestablishing corner:


Found Wexford County monument and 1 witness from Mitchell PS #28417 LCRC. This corner is accepted as a careful and faithful perpetuation of the position of the original corner being the quarter corner common to Section 1, T24N- R9W and Section 6, T24N- R8W.

C. Description of monument for corner and accessories established to perpetuate locating the position of the corner:

Wexford County Monument with Aluminum cap stamped PS 39098, 1998, E 1/4 2, ± 2' Westerly of North-South centerline and in line with fences East-West.

- N78E 27.75' 8" Cherry
- N37E 58.86' 8" Cherry
- East 34.34' Corner Fence Post
- S75W 64.82' 10" W. Pine
- S85W 169.95' 28" Maple (169.95 Mitchell)

Peer Group Reviewed and Approved  
Date: 4 December 1998  
Richard D. Wilcox  
Richard D. Wilcox, Wexford County Surveyor

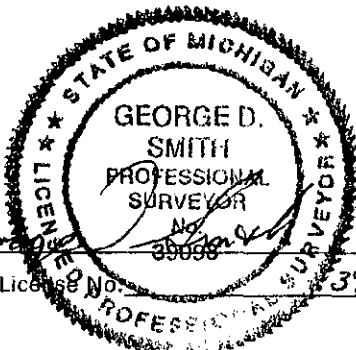

Signed by George D. Smith  
Surveyor's Michigan License No. 39098

Date 12-9-98