

RECEIVED

1998 DEC 30 PM 2: 11

LAND CORNER RECORDATION CERTIFICATE
Filing Requirement of Act 74, Mich. P.A. 1970

Linda Loughmiller
WEXFORD COUNTY, MI
REGISTER OF DEEDS

For corners in

<u>Wexford</u> (County)	Located In:	Corner Code #
1. Public Land Survey	T <u>24N</u> R <u>09W</u>	<u>M-3</u>
	T _____ R _____	_____
	T _____ R _____	_____
	T _____ R _____	_____
2. Property Controlling in Section	S _____ T _____ R _____	_____
	S _____ T _____ R _____	_____
3. Miscellaneous Property in Sec.	S _____ T _____ R _____	_____
	S _____ T _____ R _____	_____

Register of Deeds Stamp & File Number

4. Lot No. _____, Recorded Plat _____
5. Private Claims _____

I, George D. Smith, P.S., in a field survey on Nov. 9, 19 98 do hereby state that under requirements of P.A. 74, Michigan P.A. of 1970, the corner points mentioned in lines 1 and 2 above were in conformance with regulations and rules therefore as required in the current manual of survey instructions of the United States Department of the Interior, Bureau of Land Management or by a decree of a Court of Law and /or that the corner points mentioned in lines 3, 4 and 5 above were in conformance with the rules of the Michigan Board of Land Surveyors or by a Decree of a Court of Law; established, re-established, monumented, recovered, found as expressed below:

NOTE: Not more than 2 corners, all in the same town and range, may be recorded on this certificate.

	A	B	C	D	E	F	G	H	I	J	K	L	M
1													
2		6		5		4		3		2		1	
3													
4		7		8		9		10		11		12	
5													
6		18		17		16		15		14		13	
7													
8		19		20		21		22		23		24	
9													
10		30		29		28		27		26		25	
11													
12		31		32		33		34		35		36	
13													

A. Description of original monument and accessories and/or subsequent restoration:

- M-3) 1837 GLO Quarter Section Post by John Brink, Deputy Surveyor. Cedar 12" diameter for corner Sections 1 and 12
- M-3) 1853 GLO subdivision of T24N, R8W by Thomas Whelpley, Deputy Surveyor. Hemlock 8- N34 1/4 E-37; Cedar 18-S2 1/2 E-9
- M-3) 1913 Fargo Engineering Co. found remains of U.S. witnesses plainly scribed and roots of another. White Pine stump 24-S64 1/2 E-0.62 1/2; Cedar stump 10-S69W-0.88
- M-3) 1980 McCombs PS #10696 LCRC Liber 3, Page 240 found 1" pipe and crockery (Fargo) 8" Spruce N55E-23.92'; 10" Cedar N7W-36.73'; 13" Cedar N75W-34.36'; 5" Spruce S30E-5.91'


B. Description of corner evidence found and/or method applied in restoring or reestablishing corner:

Found 1" pipe and Fargo butter dishes at bottom of pipe and 1 witness from 1980 McCombs PS# 10696 LCRC. This corner is accepted as a careful and faithful perpetuation of the position of the original corner being the section corner common to sections 1 and 12 T24N-R9W and sections 6 and 7 T24N-R8W.

C. Description of monument for corner and accessories established to perpetuate locating the position of the corner:

- Set Wexford Co. brass cap inside of pipe stamped PS 39098, 1998, NE 12
- N80W 21.88' 10" Spruce, found nail
- N30W 16.95' 10" Spruce, found nail
- S85E 19.18' 14" W. Birch, set nail
- S40E 14.79' 8" Spruce, set nail
- N75W 34.96' 14" dead cedar (McCombs 34.36')

Peer Group Reviewed and Approved
Date: 12 December 1998
Richard D. Wilcox
Richard D. Wilcox, Wexford County Surveyor

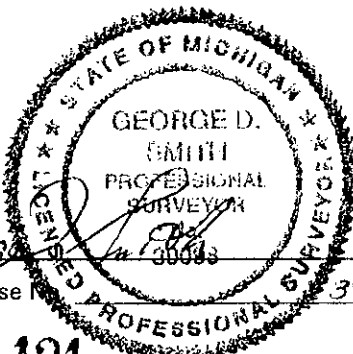

Signed by George D. Smith
Surveyor's Michigan License # 39098

Date 12-9-98