

RECEIVED

1998 DEC 30 PM 2: 11

LAND CORNER RECORDATION CERTIFICATE
Filing Requirement of Act 74, Mich. P.A. 1970

Linda Loughmiller
WEXFORD COUNTY, MI
REGISTER OF DEEDS

For corners in

<u>Wexford</u> (County)	Located In:	Corner Code #
1. Public Land Survey	T <u>24N</u> R <u>09W</u>	<u>M-4</u>
	T _____ R _____	_____
	T _____ R _____	_____
	T _____ R _____	_____
2. Property Controlling in Section	S _____ T _____ R _____	_____
	S _____ T _____ R _____	_____
3. Miscellaneous Property in Sec.	S _____ T _____ R _____	_____
	S _____ T _____ R _____	_____

Register of Deeds Stamp & File Number

4. Lot No. _____, Recorded Plat _____
5. Private Claims _____

	A	B	C	D	E	F	G	H	I	J	K	L	M
1													
2		6		5		4		3		2		1	
3													
4		7		6		9		10		11		12	
5													
6		18		17		16		15		14		13	
7													
8		19		20		21		22		23		24	
9													
10		30		29		28		27		26		25	
11													
12		31		32		33		34		35		36	
13													

I, George D. Smith, P.S., in a field survey on Oct. 30, 19 98 do hereby state that under requirements of P.A. 74, Michigan P.A. of 1970, the corner points mentioned in lines 1 and 2 above were in conformance with regulations and rules therefore as required in the current manual of survey instructions of the United States Department of the Interior, Bureau of Land Management or by a decree of a Court of Law and /or that the corner points mentioned in lines 3, 4 and 5 above were in conformance with the rules of the Michigan Board of Land Surveyors or by a Decree of a Court of Law; established, re-established, monumented, recovered, found as expressed below:

NOTE: Not more than 2 corners, all in the same town and range, may be recorded on this certificate.

A. Description of original monument and accessories and/or subsequent restoration:

- M-4) 1837 GLO Quarter Section Post by John Brink, Deputy Surveyor. Hemlock 11" diameter quarter Section corner.
- M-4) 1913 Fargo Engineering Co. found one US Witness tree down, scribed no new witnesses available
- M-4) 1980 McCombs PS #10696 LCRC Liber 3, Page 240 found 1" pipe and crockery (Fargo) 6" Pine S85 11.40', 3" Pine N30W 24.42', 3" Pine S76W 34.82', 6" Oak S27E 57.18'


B. Description of corner evidence found and/or method applied in restoring or reestablishing corner:

Found 1" pipe and 3 witnesses from 1980 McCombs PS# 10696, LCRC as noted below. This corner is accepted as a careful and faithful perpetuation of the position of the original corner being the quarter corner common to Section 12 T24N-R9W and Section 7 T24N-R8W.

C. Description of monument for corner and accessories established to perpetuate locating the position of the corner:

- Set Wexford Co. Brass cap stamped PS 39098, E 1/4 12, 1998 inside of pipe.
- S45W 18.61' 12" Poplar
- N25W 24.33' 6" Balsam (McCombs 24.42')
- S80E 11.53' 8" White Pine (McCombs 11.40')
- S25E 57.04' 6" Oak (McCombs 57.18')

Peer Group Reviewed and Approved
Date: 4 December 1998
Richard D. Wilcox
Richard D. Wilcox, Wexford County Surveyor

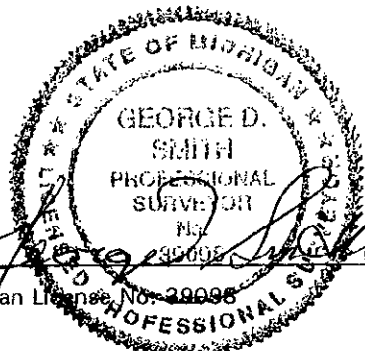

Signed by _____
Surveyor's Michigan License No. 39098

Date 12-9-98