

APR 18 1998

RECEIVED

1998 DEC 30 PM 2: 11

SECTION

LAND CORNER RECORDATION CERTIFICATE  
Filing Requirement of Act 74, Mich. P.A. 1970

*Linda Longmiller*  
WEXFORD COUNTY, MI  
REGISTER OF DEEDS

For corners in

<u>Wexford</u> (County)	Located In:	Corner Code #
1. Public Land Survey	T <u>24N</u> R <u>09W</u>	<u>M-8</u>
	T _____ R _____	_____
	T _____ R _____	_____
	T _____ R _____	_____
2. Property Controlling in Section	S _____ T _____ R _____	_____
	S _____ T _____ R _____	_____
3. Miscellaneous Property in Sec.	S _____ T _____ R _____	_____
	S _____ T _____ R _____	_____

Register of Deeds Stamp & File Number

4. Lot No. \_\_\_\_\_, Recorded Plat \_\_\_\_\_

5. Private Claims \_\_\_\_\_

	A	B	C	D	E	F	G	H	I	J	K	L	M
1													
2		6		5		4		3		2		1	
3													
4		7		8		9		10		11		12	
5													
6		18		17		16		15		14		13	
7													
8		19		20		21		22		23		24	
9													
10		30		29		28		27		26		25	
11													
12		31		32		33		34		35		36	
13													

I, George D. Smith, P.S., in a field survey on May 18, 19 98 do hereby state that under requirements of P.A. 74, Michigan P.A. of 1970, the corner points mentioned in lines 1 and 2 above were in conformance with regulations and rules therefore as required in the current manual of survey instructions of the United States Department of the Interior, Bureau of Land Management or by a decree of a Court of Law and/or that the corner points mentioned in lines 3, 4 and 5 above were in conformance with the rules of the Michigan Board of Land Surveyors or by a Decree of a Court of Law; established, re-established, monumented, recovered, found as expressed below:

NOTE: Not more than 2 corners, all in the same town and range, may be recorded on this certificate.

A. Description of original monument and accessories and/or subsequent restoration:

- M-8) 1837 GLO Quarter Section Post by John Brink, Deputy Surveyor. Cedar 10-S48W-8; Cedar 13-N20W-14
- M-8) 1981 Roser PS #12028 LCRC Liber 03, Page 258. Set Wexford County Monument equidistant and online between Northeast and Southeast corners of Section 24. 9" Cedar-N75W-23.9'; 8" Cedar-N20E-14.0'; 10" Cedar-S60E-18.0'; South edge of swamp South 90°±.

B. Description of corner evidence found and/or method applied in restoring or reestablishing corner:


Found Wexford County Monument and 2 witnesses from 1981 Roser PS #12028 LCRC. This corner is accepted as a careful and faithful re-establishment of the position of the original corner being the quarter corner common to Section 24, T24N-R9W and Section 19, T24N-R8W

C. Description of monument for corner and accessories established to perpetuate locating the position of the corner:

Wexford County monument with Aluminum cap stamped E 1/4 24, 1998, PS 39098.

- N20E 14.18' 12" Cedar (14.0; Roser)
- N75E 24.10' Twin 6" Cedar (23.9' Roser)
- S20W 17.49' 8" Hemlock
- S60E 18.38' 10" Cedar

Peer Group Reviewed and Approved  
Date: 4 December 1998  
*Richard D. Wilcox*  
Richard D. Wilcox, Wexford County Surveyor

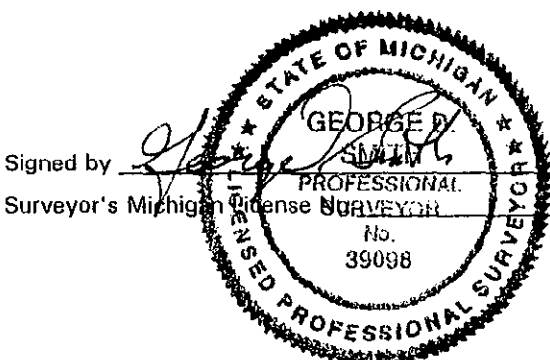

Date 12-9-98