

RECEIVED

1998 DEC 30 PM 2:11

DEC 26 1998

LAND CORNER RECORDATION CERTIFICATE
Filing Requirement of Act 74, Mich. P.A. 1970

Linda Loughmiller
WEXFORD COUNTY, MI
REGISTER OF DEEDS

For corners in

Wexford (County) Located In: Corner Code #
1. Public Land Survey T 24N R 09W M-10
2. Property Controlling in Section S T R
3. Miscellaneous Property in Sec. S T R

Register of Deeds Stamp & File Number

4. Lot No. , Recorded Plat

5. Private Claims

I, George D. Smith, P.S., in a field survey on May 18, 19 98, do hereby state that under requirements of P.A. 74, Michigan P.A. of 1970, the corner points mentioned in lines 1 and 2 above were in conformance with regulations and rules therefore as required in the current manual of survey instructions of the United States Department of the Interior, Bureau of Land Management or by a decree of a Court of Law and /or that the corner points mentioned in lines 3, 4 and 5 above were in conformance with the rules of the Michigan Board of Land Surveyors or by a Decree of a Court of Law; established, re-established, monumented, recovered, found as expressed below:

Table with 13 rows and 13 columns (A-M) containing numbers 1-36 in a grid pattern.

NOTE: Not more than 2 corners, all in the same town and range, may be recorded on this certificate.

A. Description of original monument and accessories and/or subsequent restoration:

- M-10) 1837 GLO Quarter Section Post by John Brink, Deputy Surveyor. Cedar 14" diameter for quarter section post.
M-10) 1914 E.A. Beuthien Survey in Section 30, T24N, R8W, Corner found no description given. Cedar stump 20 N023/4W 32
M-10) 1975 J.L. Wilcox PS #14102 LCRC Liber 2, Page 778. Set Wexford County Monument by retracting old survey along township line. North 25.30' FE Post; South 55.83' FE Post
M-10) 1975 J.L. Wilcox PS #14102 Certificate of Survey Liber 1, Page 356 Wexford County Monument
M-10) 1983 J.L. Wilcox PS #14102 Certificate of Survey Liber 2, Page 1, Found Wexford County Monument witnesses the same as 1975, Certificate of Survey
M-10) 1986 J. Ray PS #25869 Cert. of Survey Liber S-2 Pages 329-330 Miss. Co. Records. Found Wexford Co. Mon. in fence line north-south, no witnesses available.

B. Description of corner evidence found and/or method applied in restoring or reestablishing corner:


Found Wexford Co. Mon. in north-south fence line. This corner is accepted as a careful and faithful re-establishment of the position of the original corner being the quarter corner common to Section 25, T24N-R9W and Section 30 T24N-R8W.

C. Description of monument for corner and accessories established to perpetuate locating the position of the corner:

- Wexford Co. Mon. stamped E 1/4 25, 1998, PS 39098.
S70E 1.65' 2" Tag alder
S30E 12.31' 3" Tag alder
S80E 22.21' 4" Tag alder
S05E 9.46' 2" Tag alder

Peer Group Reviewed and Approved
Date 4 December 1998
Richard D. Wilcox, Wexford County Surveyor

Signed by George D. Smith
Surveyor's Michigan License No. 39098

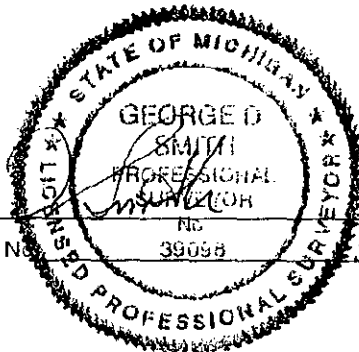

Date 12-9-98