

RECEIVED

1998 DEC 30 PM 2: 12

LAND CORNER RECORDATION CERTIFICATE
Filing Requirement of Act 74, Mich. P.A. 1970

Linda Loughmiller
WEXFORD COUNTY, MI
REGISTER OF DEEDS

For corners in

Wexford

(County)

Located In:

Corner Code #

- 1. Public Land Survey T 24N R 09W M-12
2. Property Controlling in Section S T R
3. Miscellaneous S T R
Property in Sec. S T R

Register of Deeds Stamp & File Number

4. Lot No. , Recorded Plat

5. Private Claims

I, George D. Smith, P.S., in a field survey on Dec. 28, 19 98 do hereby state that under requirements of P.A. 74, Michigan P.A. of 1970, the corner points mentioned in lines 1 and 2 above were in conformance with regulations and rules therefore as required in the current manual of survey instructions of the United States Department of the Interior, Bureau of Land Management or by a Decree of a Court of Law and for that the corner points mentioned in lines 3, 4 and 5 above were in conformance with the rules of the Michigan Board of Land Surveyors or by a Decree of a Court of Law; established, re-established, monumented, recovered, found as expressed below:

NOTE: Not more than 2 corners, all in the same town and range, may be recorded on this certificate.

Table with 13 rows and 13 columns (A-M) containing numbers 1-36 in a grid pattern.

A. Description of original monument and accessories and/or subsequent restoration:

- M-12) 1837 GLO Quarter Section Post by John Brink, Deputy Surveyor. Beech 14 S73W 47, Beech 13 N76 1/2 W 56.
M-12) 1896 A.J. Teed Survey Liber 1, Page 338, lost set new stake on line 2-3 at 1/2 distance. Sugar 10 N87 1/2 W 56, Sugar 14 S19E 17.
M-12) 1905 D.E. Teed Survey Liber 1, Page 339, found AJ's stake and witness, Sugar 20 S86 1/4 E 50.
M-12) 1915 Beuthien Survey in Section 31, T24N-R8W, C. Post, corner of S.H. S35E 1.8 (Sugar 20 S86 1/4 E 50, Teed).

B. Description of corner evidence found and/or method applied in restoring or reestablishing corner:

Set 5/8" x 18" iron with Wexford County mon. by single proportionate measure between found NE corner Section 36 and found SE corner Section 36. This corner is accepted as a careful and faithful re-establishment of the position of the original corner being the quarter corner common to Section 36, T24N, R9W and Section 31, T24N, R8W.

C. Description of monument for corner and accessories established to perpetuate locating the position of the corner:


Set 5/8" x 18" iron with Wexford County Brass Cap stamped: E 1/4 36, 1998, PS 39098.

- S72W 36.61' 24" Maple
N80W 29.83' Maple Clump 20"-18"
N50W 30.77' 8" Maple
S63E 23.45' 6" Red Pine

Peer Group Reviewed and Approved

Date: 27 December 1998

Richard D. Wilcox, Wexford County Surveyor

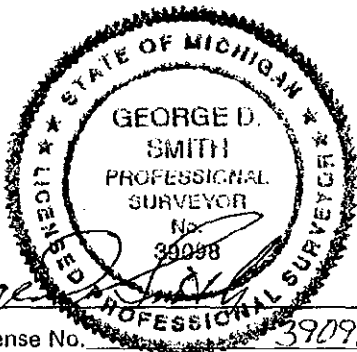

Signed by

George D. Smith

Surveyor's Michigan License No. 39098

Date 12-30-98