

LAND CORNER RECORDATION CERTIFICATE

Filing Requirement of Act 74, Mich. PA 1970


For Corners In: Wexford Located In _____ Corner Code # _____
(County)

1. Public Land Survey	T	<u>24N</u>	R	<u>9W</u>	<u>K4</u>
	T	_____	R	_____	_____
2. Property Controlling in Section	S	_____	T	_____	R
	S	_____	T	_____	R
3. Miscellaneous Property in Section	S	_____	T	_____	R
	S	_____	T	_____	R

4. Lot No: _____ Recorded Plat: _____
5. Private Claims: _____

I, Craig W. McVean, in a field survey on June 26, 2006 do hereby state that under requirements of PA 74, Michigan PA of 1970, the corner points mentioned in lines 1 and 2 above were in conformance with regulations and rules therefore as required in the current manual of survey instructions of the United States Department of the Interior, Bureau of Land Management or by a decree of a Court of Law and/or that the corner points mentioned in lines 3, 4 and 5 above were in conformance with the rules of the Michigan Board of Land Surveyors or by a Decree of a Court of Law; established, re-established, monumented, recovered, found as expressed below:

NOTE: Not more than 2 corners, all in the same town and range, may be recorded on this certificate.

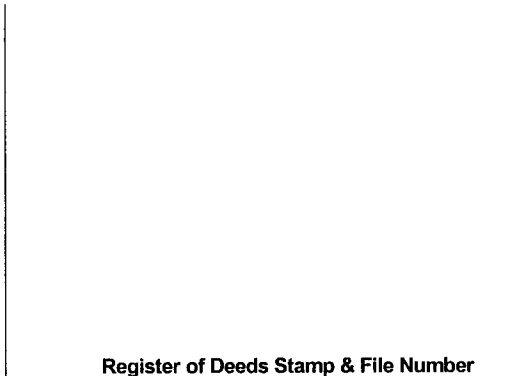

	A	B	C	D	E	F	G	H	I	J	K	L	M
1													
2	6			5			4			3		2	1
3													
4	7			8			9			10		11	12
5													
6	18			17			16			15		14	13
7													
8	19			20			21			22		23	24
9													
10	30			29			28			27		26	25
11													
12	31			32			33			34		35	36
13													

A. Description of original monument and accessories and/or subsequent restoration:


- | | |
|--|--|
| <p><u>K4</u> – 1852 – GLO – V. W. Caukin – Set ¼ post</p> <ul style="list-style-type: none"> 1) Hemlock 16" S45°W 26 L. 2) Sugar 11" N61°E 33 L. <p>- 1913 – Fargo Engineering – found remains of both U.S. Wits.
Set iron and crockery monument</p> <ul style="list-style-type: none"> 3) Sugar 14" N 3½°W 4) Sugar 20" S27°E 0.72½ | <ul style="list-style-type: none"> - 1980 – E. J. McComb – Consumer's Power Company Survey and LCRC L.3, p. 241. Found 1" pipe and crockery (Fargo) 5) 14" Maple N75°W 41.70' 6) 29" Maple N20°W 16.51' 7) 18" Maple N85°W 27.62' 8) Clump W. Cherry S15°W 37.91' |
|--|--|

B. Description of corner evidence found and/or method applied in restoring or re-establishing corner:

K4 – ¼ Corner common to Sections 11 & 12, T24N, R9W - Found ¾" I.D. x 2.3' long iron pipe w/ hooked end and fits witnesses of CPC Survey. Excavated pipe and found 2 Butter Dishes alongside. Fits 2 living and the stps. of 2 other McComb Witnesses. GLO & Fargo Witnesses are gone. ¾" iron pipe accepted as a careful and faithful perpetuation of the position of the original corner.

C. Description of monument for corner and accessories established to perpetuate locating the position of the corner:

K4 – Replaced ¾" x 2.3' long iron pipe w/ 4" DNR Alum. Cap on 1" x 36" galv. iron pipe. Placed one Butter Dish at base as a memorial. S44°E 10.05' to set N & T in NE side 6" Yellow Birch scribed 'XBT' N73°E 41.77' to set N & T in S. side of 16" S. Maple scribed 'XBT' (#5) West 27.49' to set N & T in S. side 24" S. Maple (#7) N10°W 32.54' to set N & T in E. side of 12" S. Maple scribed 'XBT' N30°E 24.08' to set N & T in NW side of 6" S. Maple Set Blue Carsonite Post 1' SE

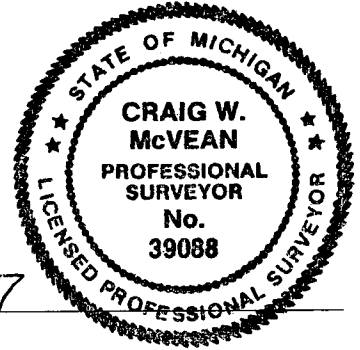

Signed by: Craig W. McVean
Surveyor's Michigan License No.: 39088

Date: 3/7/2007