

LAND CORNER RECORDATION CERTIFICATE

Filing Requirement of Act 74, Mich. PA 1970

For Corners In: <u>Wexford</u> (County)	Located In	Corner Code #
1. Public Land Survey	T <u>24N</u> R <u>9W</u>	<u>K3</u>
	T _____ R _____	_____
2. Property Controlling in Section	S _____ T _____ R _____	_____
	S _____ T _____ R _____	_____
3. Miscellaneous Property in Section	S _____ T _____ R _____	_____
	S _____ T _____ R _____	_____


4. Lot No: _____ Recorded Plat: _____

5. Private Claims: _____

I, Craig W. McVean, in a field survey on May 31, 2006 do hereby state that under requirements of PA 74, Michigan PA of 1970, the corner points mentioned in lines 1 and 2 above were in conformance with regulations and rules therefore as required in the current manual of survey instructions of the United States Department of the Interior, Bureau of Land Management or by a decree of a Court of Law and/or that the corner points mentioned in lines 3, 4 and 5 above were in conformance with the rules of the Michigan Board of Land Surveyors or by a Decree of a Court of Law; established, re-established, monumented, recovered, found as expressed below:

NOTE: Not more than 2 corners, all in the same town and range, may be recorded on this certificate.

Register of Deeds Stamp & File Number

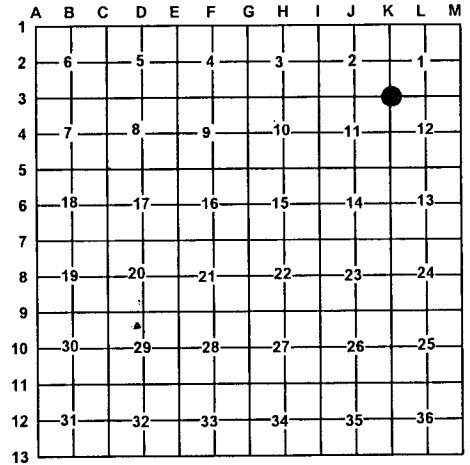

A. Description of original monument and accessories and/or subsequent restoration:

- | | |
|---|--|
| <p>K3 – 1852 – GLO – V. W. Caukin – Set post</p> <ul style="list-style-type: none"> 1) Tamarack 12" N42°E 28 L. 2) Tamarack 8" S45°W 18 L. <p>- 1913 – Fargo Engineering – Found remains of both US witnesses – Set pipe and crockery.</p> <ul style="list-style-type: none"> 3) Tamarack 10" S38°W 0.87 ¾ 4) Cedar 10" N01°W 2.28 ¼ | <p>- 1980 – J. L. Wilcox – Record Survey L. 1, p. 849 and LCRC L. 3, p. 237. Found ¾" pipe, set Wexford County Monument.</p> <ul style="list-style-type: none"> 5) N30°W 15.97' - 8" Tamarack 6) N25°E 12.78' - 10" Tamarack 7) S55°E 18.51' - 8" Tamarack 8) S69°W 12.76' - 6" Tw. Tamarack |
|---|--|

B. Description of corner evidence found and/or method applied in restoring or re-establishing corner:

K3 – Section corner common to Sections 1, 2, 11 & 12, T24N, R9W - Fd. 4" Wexford County Aluminum monument in Tamarack and cedar swamp. GLO and Fargo Witnesses are gone. Fd. Wilcox witnesses #5 & 8. Distances to 2 fd. Witnesses were off a bit (both dead or dying and leaning) but monument was firm in swamp so left as found. Added stamping S2 | S1 to cap. 4" Aluminum S11|S12

Wexford County Monument accepted as a careful and faithful perpetuation of the position of the original corner.

C. Description of monument for corner and accessories established to perpetuate locating the position of the corner:

K3 – 4" Aluminum Wexford County Monument

- S50°W 23.97' to set N & T in SE side 9" Tamarack scribed 'XBT'
- N34°W 16.16' to fd. nail in E. side dying 10" Tamarack (#5)
- S76°E 35.50' to set N & T in S. side 2" Tamarack
- S06°W 28.48' to set N & T in W. side 6" Tamarack
- N41°E 30.45' to set N & T in E. side 5" Tamarack scribed 'XBT'
- S69°W 12.53' to fd. nail in Dead Tw. Tamarack (#8)
- Set Blue Carsonite Post with loc. tag 1' S.



Signed by: Craig W. McVean
 Surveyor's Michigan License No.: 39088

Date: 3/7/07