

LAND CORNER RECORDATION CERTIFICATE

Filing Requirement of Act 74, Mich. PA 1970

For Corners In:
Wexford Located In _____ Corner Code # _____
 (County)


1. Public Land Survey	T	<u>24N</u>	R	<u>9W</u>	<u>J3</u>
	T	_____	R	_____	_____
2. Property Controlling in Section	S	_____	T	_____	_____
	S	_____	T	_____	_____
3. Miscellaneous Property in Section	S	_____	T	_____	_____
	S	_____	T	_____	_____

4. Lot No: _____ Recorded Plat: _____
 5. Private Claims: _____

I, Craig W. McVean, in a field survey on May 30, 2006 do hereby state that under requirements of PA 74, Michigan PA of 1970, the corner points mentioned in lines 1 and 2 above were in conformance with regulations and rules therefore as required in the current manual of survey instructions of the United States Department of the Interior, Bureau of Land Management or by a decree of a Court of Law and/or that the corner points mentioned in lines 3, 4 and 5 above were in conformance with the rules of the Michigan Board of Land Surveyors or by a Decree of a Court of Law; established, re-established, monumented, recovered, found as expressed below:

NOTE: Not more than 2 corners, all in the same town and range, may be recorded on this certificate.

Register of Deeds Stamp & File Number

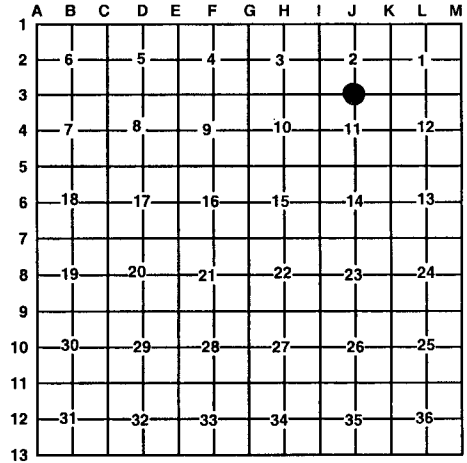

A. Description of original monument and accessories and/or subsequent restoration:

- | | |
|--|---|
| <p><u>J3</u> – 1852 – GLO – V. W. Caukin – Set ¼ post</p> <ul style="list-style-type: none"> 1) Tamarack 10" N65°W 6 L. 2) Tamarack 12" S42°E 23 L. <p>- 1913 – Fargo Engineering – No US evidence</p> <ul style="list-style-type: none"> Set pipe and crockery 3) W. Pine 12" – N64½°W 1.11½ 4) Maple 14" N5°E 2.05¼ | <ul style="list-style-type: none"> - 1980 – J. L. Wilcox – LCRC – L.3, p.237, Recorded Survey L. 1, p. 849. Fd. ¾" pipe and set Wexford County Monument. 5) S77°E 8.54' - 12" Maple 6) S19°W 17.01' - 4" W. Pine 7) S41°W 35.44' - 12" Maple 8) N23°W 35.55' - 14" Maple |
|--|---|

B. Description of corner evidence found and/or method applied in restoring or re-establishing corner:

J3 – ¼ corner common to Sections 2 & 11, T24N, R9W - Fd. 4" Aluminum capped Wexford County monument per four Wilcox witnesses. Fits one Fargo witness at N64°W 74.5' to centerline remains 12" WPS (#3). No GLO evidence. Edge of swamp is 24'± 10' East. Monument falls in transition zone 30'± 10' East of upland. GLO says edge of swamp is 40' West. GLO also calls for edge of open grass marsh 92' East vs. 154'± 50' per our measurement now. Measured Grid distance S89°34'48"E 2661.33' (2665.70' – GLO, 2655.92' – Fargo, 2662.04' – J. L. Wilcox) to 'K3' and N89°30'33"W 2656.60' (2665.70' – GLO, 2655.92' – Fargo, 2656.75' – J. L. Wilcox) to 'I-3'. Wexford County monument is accepted as a careful and faithful reestablishment of the position of the original corner.

C. Description of monument for corner and accessories established to perpetuate locating the position of the corner:

J3 – 4" Aluminum Wexford County Monument

- N22°W 3.85' to set Nail & Tag (N & T) in E. side 13" W. Pine scribed 'XBT'
- S79°E 8.52' to set N & T at fd. nail in S. side 16" R. Maple (#5)
- S15°W 16.97' to set N & T in W. side 18" W. Pine scribed 'XBT' (#6)
- S38°W 35.49' to set N & T in fd. nail in SE side 17" R. Maple (#7)
- N30°W 35.58' to set N & T in fd. nail in NE side 16" R. Maple (#8)
- Set Blue Carsonite Post with location tag 1' Northwest.



Signed by: Craig W. McVean
 Surveyor's Michigan License No.: 39088

Date: 3/15/2007