

LAND CORNER RECORDATION CERTIFICATE


Filing Requirement of Act 74, Mich. PA 1970

For Corners In: <u>Wexford</u> (County)	Located In	Corner Code #	
1. Public Land Survey	T <u>24N</u> R <u>9W</u>	<u>I-4</u>	
	T _____ R _____	_____	
2. Property Controlling in Section	S _____ T _____ R _____	_____	
	S _____ T _____ R _____	_____	
3. Miscellaneous Property in Section	S _____ T _____ R _____	_____	
	S _____ T _____ R _____	_____	
4. Lot No: _____	Recorded Plat: _____		
5. Private Claims: _____			

Register of Deeds Stamp & File Number

I, Craig W. McVean, in a field survey on Aug. 28, 2006 do hereby state that under requirements of PA 74, Michigan PA of 1970, the corner points mentioned in lines 1 and 2 above were in conformance with regulations and rules therefore as required in the current manual of survey instructions of the United States Department of the Interior, Bureau of Land Management or by a decree of a Court of Law and/or that the corner points mentioned in lines 3, 4 and 5 above were in conformance with the rules of the Michigan Board of Land Surveyors or by a Decree of a Court of Law; established, re-established, monumented, recovered, found as expressed below:

NOTE: Not more than 2 corners, all in the same town and range, may be recorded on this certificate.

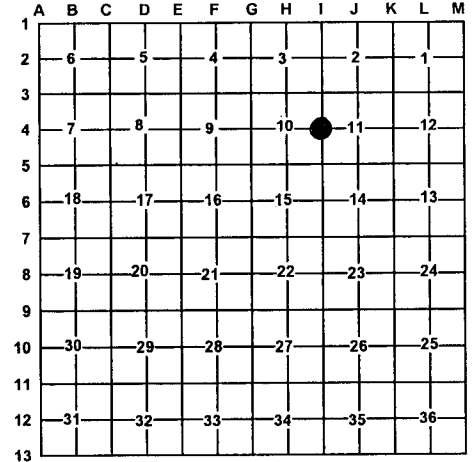

A. Description of original monument and accessories and/or subsequent restoration:

- I-4 – 1852 – Set ¼ Post – V. W. Caukins
 - 1) Cedar 6" S58°E 16 L.
 - 2) Fir 7" N45°W 35 L.
 - 12 L. North of River
- 1896 – A. J. Teed – FB #78, p. 136-141 – Ran in D (I-4).
 Sec. Cor. (I-3) from wit. and stake OK. Ran South from Hem. Sta. tree D River and find what I called one wit. = Fir from which set stake 25 Links N. of ¼ which would be in river. This is as good as it can now get. 3) D – Cedar 14" N73°W 29 L.
- 1913 – Fargo Eng. – No U.S. evidence. ¼ post in river. Set Wit. Cor. 1.55 ¾ S. of P. R. Corner. 4) Cedar 12" S45°E 0.60
- 5) Cedar 18" S23½°W 0.55½
- 1999 - Gourdie Fraser Notes – Job #995337 – Fd. Fargo pipe for Witness Corner. 6) S35°E 40.36' – 20" soft Maple;
- 7) S40°W 4.0' – 18" Cedar; 8) S77°W 24.67' – 8" Cedar;
- 9) N65°W 11.65' – 12" Balsam

B. Description of corner evidence found and/or method applied in restoring or re-establishing corner:

I-4 – ¼ Corner common to Sec. 10 & 11 – Corner position in Manistee River as noted by Teed and Fargo. Searched for Teed stake 25 Links N. of corner in river but could not find it. Teed wit. cor. position would also appear to be in river now. Fd. ¾" x 1.9' hooked end pipe w/ 2 Butter dishes on S. Bank of River for Witness Corner noted by Fargo. Calculated 'I-4' corner position in river by projecting E. line of Sec. 10 from 'I-5' (calculated Fargo proportional position in Manistee River) N2°11'39"E 2527.69' (2527.47' – FE) to and through Witness Corner at N2°11'39"E 102.81' (102.8' – FE) to 'I-4' in River. From 'I-4' (in river) N2°22'34"E 2626.11' (2630.27' – Fargo) to 'I-3'. Also set POL's at N2°22'34"E 50.00' on Sec. line to North of 'I-4' and S89°19'42"E 465.0' of 'I-4' on E-W ¼ line of Sec. 11. Calculated Fargo 'I-4' position in Manistee River accepted as a careful and faithful reestablishment of the position of the original corner.

C. Description of monument for corner and accessories established to perpetuate locating the position of the corner:

- I-4 – In River – Description and Witnesses of Witness Cor. and Points on Line (POL).
 - Witness Corner on Sec. Line S2°11'39"W 102.81' of 'I-4'
 Replaced fd. ¾" x 1.9' Fargo pipe w/ 4" DNR Alum. Cap on 1" x 3' long galv. iron pipe. Add butter dish as memorial.
 Set Blue Carsonite Post w/ loc. tag 1' SW
 S36°W 3.94' to fd. nail in SE side 20" Cedar (#7)
 S38°E 40.38' to fd. nail in SW side 16" S. Maple (#6)
 N72°W 11.54' to fd. nail in S. side 13" Fir (#9)
 S70°W 24.62' to fd. nail in SE side 11" Cedar (#8)
 N 4' to Edge of River.
 - POL on Sec. Line – N2°22'34"E 50.00' of 'I-4' – Set 2" Alum. Cap on 5/8" x 34" rebar. Set Blue Carsonite Post 1' West. South 30' to N. Edge of River. N56°E 10.79' to set N & T in SE side 7" W. Pine; N49°W 31.55' to set N & T in NE side 6" S. Maple
 - POL on E-W ¼ Line, Sec. 11 – S89°19'42"E 465.0' of 'I-4' – Set 2" Alum. Cap on 5/8" x 34" rebar on high bank of River. Set Blue Carsonite Post 1' South. S53°E 23.84' to set N & T in SW side 16" Oak; N38°E 33.98' to set N & T in NW side 6" W. Pine

* Note = All Section line measured distances are in International Grid feet.

Signed by: Craig W. McVean
 Surveyor's Michigan License No.: 39088

Date: 3/15/2007

