

LAND CORNER RECORDATION CERTIFICATE

Filing Requirement of Act 74, Mich. PA 1970

For Corners In:
Wexford Located In _____ Corner Code # _____
 (County)


1. Public Land Survey	T	<u>24N</u>	R	<u>9W</u>	<u>I-3</u>
	T	_____	R	_____	_____
2. Property Controlling in Section	S	_____	T	_____	R
	S	_____	T	_____	R
3. Miscellaneous Property in Section	S	_____	T	_____	R
	S	_____	T	_____	R

4. Lot No: _____ Recorded Plat: _____
 5. Private Claims: _____

I, Craig W. McVean, in a field survey on June 8, 2006 do hereby state that under requirements of PA 74, Michigan PA of 1970, the corner points mentioned in lines 1 and 2 above were in conformance with regulations and rules therefore as required in the current manual of survey instructions of the United States Department of the Interior, Bureau of Land Management or by a decree of a Court of Law and/or that the corner points mentioned in lines 3, 4 and 5 above were in conformance with the rules of the Michigan Board of Land Surveyors or by a Decree of a Court of Law; established, re-established, monumented, recovered, found as expressed below:

NOTE: Not more than 2 corners, all in the same town and range, may be recorded on this certificate.

Register of Deeds Stamp & File Number

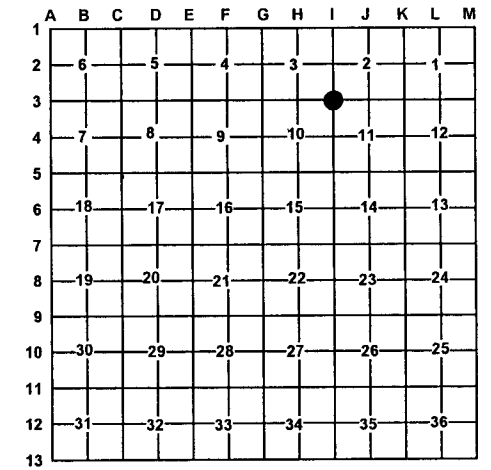

A. Description of original monument and accessories and/or subsequent restoration:

- | | |
|--|---|
| <p><u>I-3</u> – 1852 – GLO – V. W. Caukin – Set post corner</p> <ul style="list-style-type: none"> 1) W. Pine 14" N55°W 10 L. 2) Beech 8" S25°E 38 L. <p>- 1896 – CSR – A. J. Teed, book 78, p. 138</p> <p>Fd. stake and wits. O.K.</p> <ul style="list-style-type: none"> 3) W. Pine 18" S82°E 15 L. <p>-1913 – Fargo Engineering – Fd. Iron pipe and remains of GLO wits.</p> <ul style="list-style-type: none"> 4) Y. Pine 8" N13°E. 0.70 5) Y. Pine stp. S39°W 0.70 6) W. Pine stp. 14" N55°W 0.16 | <p>- 1980 – J. L. Wilcox – LCRC – L. 3, p. 237 and Rec. Sur., L. 1, p. 849 - found 1 1/2" pipe - 0.5' below ground, set Wex. Co. Monument.</p> <ul style="list-style-type: none"> 7) S84°E 8.10' - 5" W. Pine 8) S26°E 44.61' - 14" W. Pine 9) N21°E 45.05' 16" R. Pine 10) N63°E 20.48' - 5" W. Pine |
|--|---|

B. Description of corner evidence found and/or method applied in restoring or re-establishing corner:

I-3 – Section corner common to Sections 2, 3, 10 & 11, T24N, R9W - Fd. 4" Aluminum capped Wexford County monument per J. L. Wilcox. Fd. one remaining Fargo witness and 4 Wilcox witnesses. Added stamping S3 | S2 to cap. Wexford County S10 | S11 monument accepted as a careful and faithful perpetuation of the position of the original corner.

C. Description of monument for corner and accessories established to perpetuate locating the position of the corner:

- I-3 – 4" Aluminum stamped cap Wexford County Monument.
- N12°E 46.54' to set N & T in W. side 15" R. Pine scribed 'XBT' (#4)
 - N14°E 45.04' to set N & T at fd. nail in W. side 22" R. Pine (#9)
 - N56°E 20.47' to set N & T at fd. nail in SE side 11" W. Pine (#10)
 - S86°E 8.12' to set N & T at fd. nail in S. side 10" W. Pine (#7)
 - S29°E 44.49' to set N & T at fd. nail in W. side 24" W. Pine (#8)
- Set Blue Carsonite Post with location tag 1' Northwest



Signed by: Craig W. McVean
 Surveyor's Michigan License No.: 39088

Date: 3/7/2007