

LAND CORNER RECORDATION CERTIFICATE

Filing Requirement of Act 74, Mich. PA 1970



For Corners In: Wexford (County)	Located In	Corner Code #
1. Public Land Survey	T <u>24N</u> R <u>9W</u>	<u>I-2</u>
2. Property Controlling in Section	S _____ T _____ R _____	_____
3. Miscellaneous Property in Section	S _____ T _____ R _____	_____

4. Lot No: _____ Recorded Plat: _____

5. Private Claims: _____

I, Craig W. McVean, in a field survey on June 1, 2006 do hereby state that under requirements of PA 74, Michigan PA of 1970, the corner points mentioned in lines 1 and 2 above were in conformance with regulations and rules therefore as required in the current manual of survey instructions of the United States Department of the Interior, Bureau of Land Management or by a decree of a Court of Law and/or that the corner points mentioned in lines 3, 4 and 5 above were in conformance with the rules of the Michigan Board of Land Surveyors or by a Decree of a Court of Law; established, re-established, monumented, recovered, found as expressed below:

NOTE: Not more than 2 corners, all in the same town and range, may be recorded on this certificate.

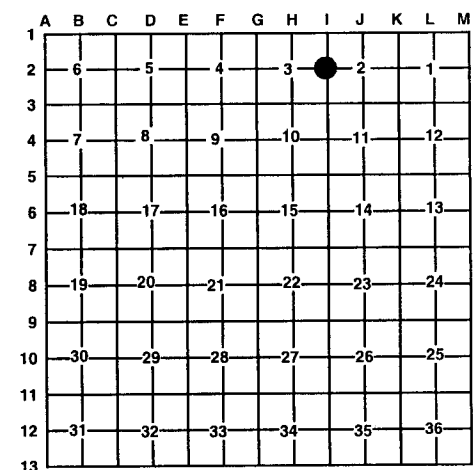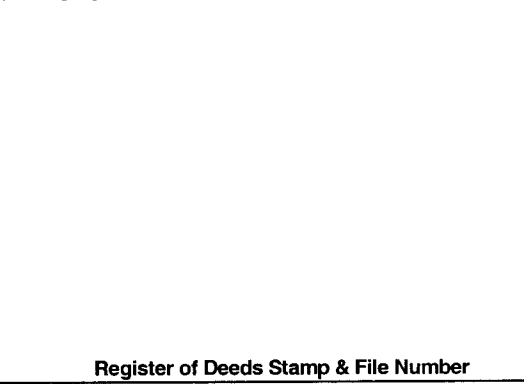

A. Description of original monument and accessories and/or subsequent restoration:

- I-2 – 1852 – GLO – V. W. Caukin – Set ¼ post
 - 1) S. Pine 10" N46°W 10 L.
 - 2) S. Pine 10" S12°E 11 L.
- 1913 – Fargo Engineering – No US evidence
 - Set iron crockery monument.
 - 3) S. Pine 9" S83°E 28 ½
 - 4) S. Pine 9" S89°W 39
- 1964 – P. H. Jones – Subdivision of "Chippewa Creeksites" –
 - L. 5 of plats on P. 154 - concrete mon.
- 1980 – LCRC L. 3, p. 236 - J. L. Wilcox – Fd. conc. mon.
 - Set Wexford Co. mon.
 - 5) N12°W 18.78' 10" J. Pine
 - 6) N62°E 17.04' 10" J. Pine
 - 7) S80°E 10.48' 8" J. Pine
 - 8) S02°E 15.57' 8" J. Pine

B. Description of corner evidence found and/or method applied in restoring or re-establishing corner:

I-2 – ¼ Corner common to Sections 3 & 2, T24N, R9W - Fd. 4" Wexford County Aluminum monument, heaved up and leaning. Excavated County monument and found one broken butterdish with monument. Also found Fargo hooked-end pipe 5'± to West, lying on ground. GLO and Fargo witnesses are gone. Reset 4" x 30" Co. Aluminum monument per found nails from three Wilcox BT's. Placed butterdish at base as memorial. Added stamping "1/4 S3|S2" to Monument. Measured Grid distance of N2°22'38"E 2813.64' (2822.82' – GLO, 2811.6' – Fargo) to 'I-1' and S2°25'07"W 2615.69' (2629.44' – GLO, 2618.88' – Fargo, 2615.98' – J. L. Wilcox) to 'I-3'. 4" x 30" Wexford County Aluminum monument is accepted as a careful and faithful reestablishment of the position of the original corner.

C. Description of monument for corner and accessories established to perpetuate locating the position of the corner:

- I-2 – 4" x 30" Wexford County Aluminum monument
 - S51°W 7.43' to set Nail & Tag (N & T) in SE side 7" Oak scribed 'XBT'
 - N56°W 31.74' to set N & T in SW side 7" Oak scribed 'XBT'
 - S85°E 10.48' to set N & T at fd. nail in S. side 11" J. Pine (#7)
 - N59°E 17.02' to set N & T at fd. nail in SE side 12" J. Pine (#6)
 - S02°E 15.57' to fd. nail in W. side dead 10" J. Pine (#8)
 - S24°E 47.56' to set N & T in N. side 10' W. Pine scribed 'XBT'
 - Set Blue Carsonite Post 1' Southwest



Signed by: Craig W. McVean
 Surveyor's Michigan License No.: 39088

Date: 3/15/2007