

# LAND CORNER RECORDATION CERTIFICATE

Filing Requirement of Act 74, Mich. PA 1970



For Corners In:  
Wexford Located In \_\_\_\_\_ Corner Code # \_\_\_\_\_  
 (County)

- |                                      |   |            |   |           |           |
|--------------------------------------|---|------------|---|-----------|-----------|
| 1. Public Land Survey                | T | <u>24N</u> | R | <u>9W</u> | <u>H3</u> |
|                                      | T | _____      | R | _____     | _____     |
| 2. Property Controlling in Section   | S | _____      | R | _____     | _____     |
|                                      | S | _____      | R | _____     | _____     |
| 3. Miscellaneous Property in Section | S | _____      | R | _____     | _____     |
|                                      | S | _____      | R | _____     | _____     |

4. Lot No: \_\_\_\_\_ Recorded Plat: \_\_\_\_\_  
 5. Private Claims: \_\_\_\_\_

I, Craig W. McVean, in a field survey on Jan. 17, 2006 do hereby state that under requirements of PA 74, Michigan PA of 1970, the corner points mentioned in lines 1 and 2 above were in conformance with regulations and rules therefore as required in the current manual of survey instructions of the United States Department of the Interior, Bureau of Land Management or by a decree of a Court of Law and/or that the corner points mentioned in lines 3, 4 and 5 above were in conformance with the rules of the Michigan Board of Land Surveyors or by a Decree of a Court of Law; established, re-established, monumented, recovered, found as expressed below:

**NOTE: Not more than 2 corners, all in the same town and range, may be recorded on this certificate.**

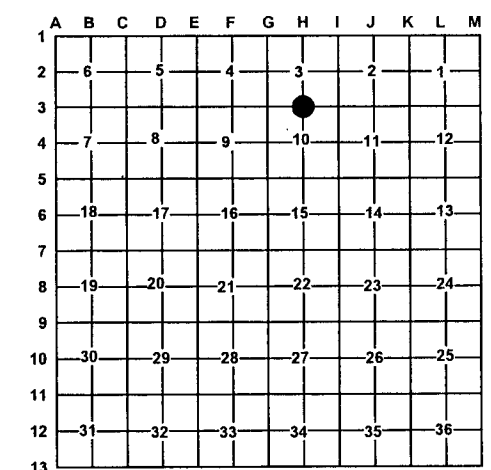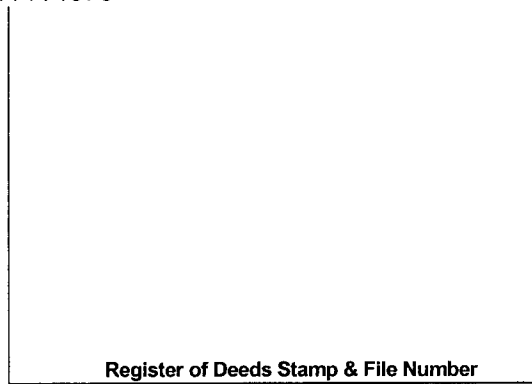

**A. Description of original monument and accessories and/or subsequent restoration:**

- |   |   |
|---|---|
| <p><u>H3</u> – 1852 – GLO – Caukin – Set ¼ post</p> <ul style="list-style-type: none"> <li>1) Y. Pine 18" S20°W 12 L.</li> <li>2) Y. Pine 16" N58°E 95 L.</li> </ul> <p>- 1913 – Fargo Engineering – Found both U.S. witnesses.</p> <ul style="list-style-type: none"> <li>Set iron and crockery monument.</li> <li>3) Y. Pine 18" S20°W 0.12</li> <li>4) Y. Pine stp. 4" S11°E 0.90 ¾</li> <li>5) W. Oak 12" N87°W 1.62 ¾</li> </ul> | <p>- 2003 – Gourdie Frasier notes – Fd. 1" pipe</p> <ul style="list-style-type: none"> <li>6) N20°E 16" W. Pine 75.18'</li> <li>7) S88°E 18" W. Pine 61.05'</li> <li>8) S45°W 6" Twin White Oak 50.18'</li> <li>9) N62°W 6" W. Oak 35.43'</li> <li>5) Fd. 30" Oak w/ blaze N83°W 107.00'</li> </ul> |
|---|---|

**B. Description of corner evidence found and/or method applied in restoring or re-establishing corner:**

H3 – ¼ Corner common to Sections 3 & 10, T24N, R9W - Fd. ¾" x 2.3' long iron pipe with hooked end and two broken butter dishes per Fargo Engineering. Found one original GLO wit. (#2), two Fargo Engineering wits. (#4 & 5) and Gourdie-Frasier wits. in agreement with pipe. ¾" iron pipe accepted as a careful and faithful perpetuation of the position of the original corner.

**C. Description of monument for corner and accessories established to perpetuate locating the position of the corner:**

H3 – Replaced ¾" Fargo pipe with a 4" DNR Aluminum cap on 1" x 3' long galvanized iron pipe.  
 Placed crockery at base of pipe as memorial.  
 S40°W 50.13' to fd. nail in SE side 8" W. Oak (#8)  
 N70°W 35.50' to fd. nail in S. side 9" R. Maple (#9)  
 N15°E 75.21' to fd. nail in W. side 17" W. Pine (#6)  
 East 60.91' to fd. nail in S. side 20" W. Pine (#7)  
 N59°E 63.25' to set spike in centerline remains of 16"± Yellow Pine stump (#2)  
 N87°W 107.8'± to centerline of recently cut 30" Oak Stump (#5)  
 Set Blue Carsonite Post 1' North



Signed by: Craig W. McVean  
 Surveyor's Michigan License No.: 39088

Date: 3/15/2007