


# LAND CORNER RECORDATION CERTIFICATE

Filing Requirement of Act 74, Mich. PA 1970

For Corners In: <u>Wexford</u> (County)	Located In T <u>24N</u> R <u>9W</u>	Corner Code # <u>G5</u>
1. Public Land Survey	T _____ R _____	_____
2. Property Controlling in Section	S _____ T _____ R _____	_____
3. Miscellaneous Property in Section	S _____ T _____ R _____	_____

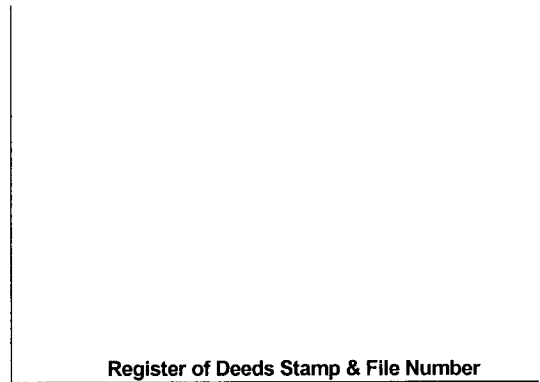


4. Lot No: \_\_\_\_\_ Recorded Plat: \_\_\_\_\_

5. Private Claims: \_\_\_\_\_

I, Craig W. McVean, in a field survey on Aug. 29, 2006 do hereby state that under requirements of PA 74, Michigan PA of 1970, the corner points mentioned in lines 1 and 2 above were in conformance with regulations and rules therefore as required in the current manual of survey instructions of the United States Department of the Interior, Bureau of Land Management or by a decree of a Court of Law and/or that the corner points mentioned in lines 3, 4 and 5 above were in conformance with the rules of the Michigan Board of Land Surveyors or by a Decree of a Court of Law; established, re-established, monumented, recovered, found as expressed below:

**NOTE: Not more than 2 corners, all in the same town and range, may be recorded on this certificate.**

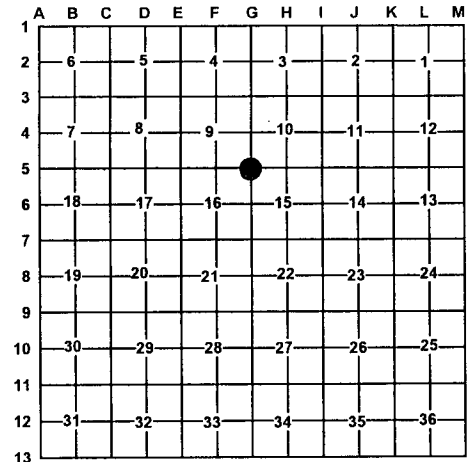

**A. Description of original monument and accessories and/or subsequent restoration:**

- G5 – 1852 – GLO Sec. Post by V. W. Caukin Deputy Surveyor  
 1) Beech 8" S45°W 24'; 2) Beech 10" N40°E 38'  
 - 1896 – A. J. Teed Survey L.1, p.327, FB#78, p.138-139; fd. no corner.  
 - 1913 – Fargo Eng. Co. - fd. no evidence of corner; Set stake for Sec. Corner. 3) W. Pine Stump 24 S26°E 48';  
 4) W. Pine Stump 20" N7½°E 22'  
 - 1920 – 40's - Marcus Schaaf Deputy forester and surveyor line notes; Notes indicated set 2" pipes in concrete as a typical monument in fire trails; No witnesses available  
 - 1980 – McCombs PS#10696 – Consumer Power Co. – Drawing # S-F 17406 - Fd. 2" pipe in centerline dirt Rd;  
 5) 27" Maple S33°W 47.60'; 6) 7" J. Pine S25°E 51.85';  
 7) 4" W. Cherry N42°W 33.16'; 8) 6" J. Pine S47°E 48.5'  
 - 1994 – Carter PS#33973 - LCRC L. 4, p. 251 - Fd. 2" pipe in concrete-  
 9) N10°E 32.5' Face of Cedar Post; 10) S20°E 37.52' Spike Nail in 12" Twin R. Pine; 5) S40°W 47.63' Spike Nail in 24" Maple;  
 7) N35°W 33.20' N & T in 6" Cherry; 11) N80°E 91.78' nail in 4" R.Pine  
 - 1995 – Roser PS#12028 LCRC Liber 4, p. 344 - Fd. short 2" pipe in 1' diameter irregular concrete block for SE corner Section 9. Fd. Mon. buried 7" in approximately ctr. E-W dirt road and in ctr. Firelane looking south. Corner probably set by Marcus Schaaf. Fd. pieces of Fargo Eng. 1913 Butter Dish. Fd. remains of Fargo Eng. 1913 wit. NE that fits Monument. 7) 6" B. Cherry N40°W 33.14'; 11) 3" R. Pine N80°E 91.78'; 12) 11" Twin R. Pine S20°E 67.47';  
 5) 23" Maple S30°W 47.58'
- 2001 – J. Curtis PS#43048 - LCRC L. 5, p. 358 - Fd. 50mm iron pipe – 7) N40°W 33.20' fd. Ref. Tag 250mm Dead Cherry; 5) S35°W 47.58' Fd. Ref. Tag 700mm Maple; 12) S15°E 67.50' Fd. Ref. Tag 500mm Twin Pine; 13) S65°E 79.53' Set nail / Ref. tag 455mm Pine; (14) N85°E 91.83 – Set nail – Ref. Tag 300mm Pine  
 - 2003 – LCRC – L. 5, p. 175 – G. D. Smith – Fd. 2" pipe in irregular concrete, which is a typical monument set by Marcus Schaaf in the 1920's and 2 wits. from Roser's 1995 LCRC. In 1995, Roser found pieces of Fargo's 1913 butter dish and remains of Fargo witness to the NE that fits monument, excavated area around pipe but did not find butter dish pieces or witness to the NE, all witnesses falling within 33.0' N or S of section line have been destroyed due to improvements by WCRC. Accepted this 2" pipe as reestablished by Fargo in 1913 as a careful and faithful reestablishment of the position of the original corner, being the Section corner common to Sections 9, 10, 16 & 15, T24N, R09W. Fd. 2" pipe in irregular concrete in centerline trail E-W and on W. edge of trail S. Set Wex. Co. brass cap stamped 39098, 2003, 9, 10, 15, 16 inside of pipe. 12) S16°E 67.49' - 14" Twin Red Pine, Fd. nail; 5) S36°W 47.59' – 24" Maple, Fd. nail; 9) N09°E 32.58' Cedar Post, set nail; 15) S47°E 68.47' 15" Red Pine, set nail; 16) N62°W 68.07' – 7" Oak, set nail

**B. Description of corner evidence found and/or method applied in restoring or re-establishing corner:**

G5 – Sec. Corner common to Sec. 9, 10, 15 & 16 – No evidence of Wexford Co. Brass Cap. Fd. 2" pipe w/ concrete around – Down 2.2' – 2'± N. of centerline of E-W Gravel Rd. Fits Witnesses of record. Common Schaaf monument in area. 2" pipe in conc. accepted as a careful and faithful reestablishment of the position of the original corner.

**C. Description of monument for corner and accessories established to perpetuate locating the position of the corner:**

G5 – Raised 2" pipe in concrete w/ stamped 1½" Wexford Co. Brass Cap on 5/8" x 1.9' long iron rebar w/ 4" x 6" PVC w/ conc. around cap – Down 8".  
 North 32.58' to fd. nail in E. side Cedar post w/ loc. tag (#9)  
 S20°E 67.48' to fd. nail in W. side Tw. 14" & 8" R. Pine (#12)  
 S29°W 47.57' to fd. nail in NW side 27" R. Maple (#5)  
 S54°E 68.49' to set N & T at fd. nail in NE side 14" R. Pine (#15)  
 N61°W 68.01' to set N & T at fd. nail in SW side 8" Oak (#16)  
 N72°E 90.69' to set N & T at fd. nail in SE side 5" J. Pine (#14)

Signed by: Craig W. McVean  
 Surveyor's Michigan License No.: 39088

Date: 3/7/2007

