LAND CORNER RECORDATION CERTIFICATE

Filing Requirement of Act 74, Mich. PA 1970

For Corners In:
Wexford
(County)

		Located In		Corner Code #
1. Public Land Survey		T ____	R ____	____
		T ____	R ____	____
2. Property Controlling in Section	S 10	T 24N	R 9W	12
	S 10	T 24N	R 9W	14
3. Miscellaneous Property in Section	S ____	T ____	R ____	____
	S ____	T ____	R ____	____

Register of Deeds Stamp & File Number

4. Lot No: _____ Recorded Plat: _____

5. Private Claims: _____

I, Craig W. McVean, in a field survey on Aug. 30, 2006 do hereby state that under requirements of PA 74, Michigan PA of 1970, the corner points mentioned in lines 1 and 2 above were in conformance with regulations and rules therefore as required in the current manual of survey instructions of the United States Department of the Interior, Bureau of Land Management or by a decree of a Court of Law and/or that the corner points mentioned in lines 3, 4 and 5 above were in conformance with the rules of the Michigan Board of Land Surveyors or by a Decree of a Court of Law; established, re-established, monumented, recovered, found as expressed below:

NOTE: Not more than 2 corners, all in the same town and range, may be recorded on this certificate.

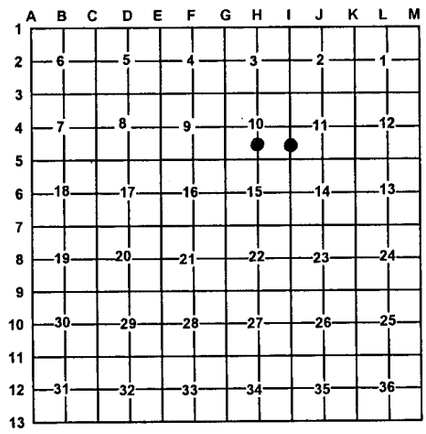

A. Description of original monument and accessories and/or subsequent restoration:

12 - None

14 - None

STATE OF MICHIGAN
CRAIG W. McVEAN
PROFESSIONAL SURVEYOR
No. 39088
LICENSED PROFESSIONAL SURVEYOR

B. Description of corner evidence found and/or method applied in restoring or re-establishing corner:

12 – CS 1/16 Corner, Sec. 10 – Set stamped 2" Alum. Cap on 5/8" x 34" rebar per Standard BLM procedure.
North 36'± to SW'ly edge of Manistee River – Course NW.
East 46'± to SW'ly edge at Manistee River.

14 – S 1/16 Corner common to Sections 10 & 11 - Set 2" Alum. Cap on 5/8" x 34" rebar per Standard BLM procedure.
South 17'± to N'ly edge of Manistee River.
West 47'± to NW'ly edge of Manistee River.

C. Description of monument for corner and accessories established to perpetuate locating the position of the corner:

12 – Stamped 2: Alum. Cap on 5/8" x 34" rebar.
Set Blue Carsonite Post w/ loc. tag 1' NW
N29°E 17.71' to set N & T in SE side 18" Cedar
S02°E 48.67' to set N & T in W. side 14" Cedar
S63°W 20.15' to set N & T in S. side 7" Fir
N59°W 48.92' to set N & T in SW side 24" Cedar

14 – Stamped 2" Alum. Cap on 5/8" x 34" rebar.
Set Blue Carsonite Post w/ loc. tag 1' NE
N25°E 27.62' to set N & T in W. side 20" S. Maple
N71°E 10.56' to set N & T in N. side 6" Fir
S81°E 23.05' to set N & T in N. side 9" W. Pine
N80°W 3.01' to set N & T in S. side 13" W. Pine

Signed by: Craig W. McVean Date: 3/15/2007

Surveyor's Michigan License No.: 39088

FORM APPROVED BY MICHIGAN STATE BOARD OF PROFESSIONAL SURVEYORS JAN. 28, 1971
Revised May 14, 1975
Revised Jan. 1983
Revised Oct. 1995