

LAND CORNER RECORDATION CERTIFICATE

FILING REQUIREMENT OF ACT 74, MICH. P.A.1970

FOR CORNERS OF --:	LOCATED IN --:	CORNER CODE NUMBER
1. PUBLIC LAND SURVEY	T. 24 N. R. 10	F-3;F-4;F-5;G-3;G-4
2. PROPERTY CONTROLLING IN SECTION	T. S. R. E. W.	
3. MISCELLANEOUS PROPERTY IN SECTION	T. S. R. E. W.	
4. LOT NO. _____, RECORDED PLAT _____		
5. PRIVATE CLAIMS _____		

REGISTER OF DEEDS STAMP AND
FILING NUMBER

I, Carl F. Roser do hereby certify that under requirements of P.A. 74, Michigan P.A. of 1970, the corner points mentioned in lines 1 and 2 above (identified with circles on index code diagram - over) were, in a field survey on November 25, 1974, established, re-established, monumented, re-monumented, recovered or restored as expressed below and in conformance with regulations and rules therefore as required in the current manual of survey instructions of the United States Department of the Interior, Bureau of Land Management or by a decree of a court of law. Furthermore, that the corner points mentioned in lines 3, 4 and 5 above were, in a field survey on _____ 19____, found, recovered, restored, established or re-established as expressed below and in conformance with the rules of the Michigan State Board of Registration for Land Surveyors or, by a Decree of a Court of law:

A. Description of original monument and accessories and of subsequent restoration

C. (continued)

G-3	G-4
Set std. Wexford Co. mon.	Found Fargo pipe & added std. Wexford County monument
8" Balsam N18°E 40.25	8" R. Pine N35°W 29.68
14" Maple N83°E 43.17	16" Maple N72°E 65.80
12" Maple S18°E 62.95	ROW fence corner post N57°E 34.43
set cedar post w/loc. tag Due N 10'	set loc. tag on ROW fence post Due N 22'

B. Description of corner evidence found and/or method applied in restoring or re-establishing corner:


- F-3 Found 1" iron in approximate center of N-S blacktop road, in line with fences E & W. Corner fits county road witnesses.
- F-4 Established center of Sec. 9 at intersection of 1/4 lines. This position fits distance east to E 1/4 corner within 7 ft. to what E.E. Sours measured in May 1913.
- F-5 Recovered Fargo pipe in W'ly wheel track of N-S trail road. Corner fits remains of all three Fargo witnesses.
- G-3 Recovered bottom on conc. mon. and crockery, that had been dozed out at N'ly edge of drive to cabin. Corner as recovered fits Fargo witn. (cedar stump) SE and survey part of SW 1/4 of Sec. 3 (24-10) by Gourdie-Batler, Job No. 67119, 8/5/67. (OVER)

C. Description of monument for corner and accessories established to perpetuate locating the position of the corner:

F-3	F-4	F-5
Found 1" iron rod	Set 1"x24" pipe, buried 0.5'	found Fargo pipe & added std. Wexford County monument
9" Oak S72°W 58.17	8" R. Pine N33°W 70.0	18" Oak S40°W 77.2
9" Maple S39°E 73.45	7" R. Pine N70°W 46.2	18" Oak S33°E 76.4
set cedar post w/loc. tag Due E 33'	7" R. Pine S43°W 79.0	10" Oak N37°E 132.2
	set cedar post w/loc. tag Due W 33'	set cedar post w/loc. tag Due E 33'
	center N-S dirt road Due E 3'	

SIGNED BY Carl F. Roser DATE 1-16-75

SURVEYOR'S MICHIGAN REGISTRATION NO. 12028

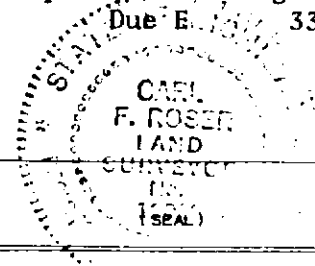

FOR STATE AND UNITED STATES AGENCIES:

SIGNED BY _____ DATE _____
CHIEF OF SURVEY PARTY

APPROVED AND SIGNED BY _____ DATE _____
MICHIGAN REGISTERED LAND SURVEYOR

SURVEYOR'S MICHIGAN REGISTRATION NO. _____

GREENWOOD TOWNSHIP
WEXFORD COUNTY