

MICHIGAN
DEPARTMENT OF CONSERVATION
FORESTRY DIVISION

LAND CORNER RECORD

T. 24 N.R. 10 W.


Wexford COUNTY

DESCRIPTION OF CORNER Section corner common to Sections 29 - 30 - 31 - 32

CORNER MONUMENT Set 1" pipe with 4" brass cap

DATE MONUMENT PLACED AND WITNESSED April 25, 1962

WITNESSES TO CORNER.....

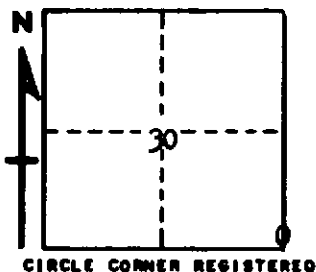

5" Maple N 11 E - 35.5'
7" Maple S 18 E - 38.1'
AND
5" Maple S 65 W - 46.6'

DESCRIPTION IN DETAIL AS TO HOW CORNER WAS LOCATED AND IDENTIFIED OR RESTORED.

This corner was found while making a survey in this area. Found a 2" pipe at corner as established by Marcus Schaaf, R.L.S. in 1938, from sites of U.S. BTs. This point checks very well for line and measurement over good 1/4 and section corner north. Checks okay to stream crossings in four directions, and for measurement and line to section corner west. This corner was used in a previous survey to establish the 1/4 corner between 29 - 32 as well as the E 1/8 corner. Sufficiently supported to be considered acceptable as proper position for corner.

SURVEYOR'S SEAL

SIGNED *Kenneth J. Bethune* DATE April 27, 1962
REGISTERED LAND SURVEYOR