

LAND CORNER RECORDATION CERTIFICATE

FILING REQUIREMENT OF ACT 74, MICH. P.A.1970

FOR CORNERS OF--	LOCATED IN--	CORNER CODE NUMBER
1. PUBLIC LAND SURVEY	T. 24 N. R. 10 W.	E-3, E-5
2. PROPERTY CONTROLLING IN SECTION	9, T. 24 N. R. 10 W.	5
3. MISCELLANEOUS PROPERTY IN SECTION	9, T. 24 N. R. 10 W.	661.95 N OF F-4
4. LOT NO. _____, RECORDED PLAT _____		
5. PRIVATE CLAIMS _____		

REGISTER OF DEEDS STAMP AND FILING NUMBER

I, CARL F. ROSER, do hereby certify that under requirements of P.A. 74, Michigan P.A. of 1970, the corner points mentioned in lines 1 and 2 above were, in a field survey on 6/18, 1984, established, re-established, monumented, re-monumented, recovered or restored as expressed below and in conformance with regulations and rules therefore as required in the current manual of survey instructions of the United States Department of the Interior, Bureau of Land Management or by a decree of a court of law. Furthermore, that the corner points mentioned in lines 3, 4 and 5 above were, in a field survey on 6/18, 1984, found, recovered, restored, established or re-established as expressed below and in conformance with the rules of the Michigan State Board of Registration for Land Surveyors or, by a Decree of a Court of law:

C. (CONTINUED)

<p style="text-align: center;">5</p> <p>DROVE 5/8" X 34" REROD W/RLS CAP & SET CED POST W/LOC TAG.</p> <p>9" R PINE N88°E 60.26</p> <p>24" + ELM STP S08°E 40.55</p> <p>DROVE 3/8" X 36" PIPE N89°26'E 99.96</p> <p>CTR EXIST N-S WEST 31'±</p> <p>B. TOP</p>	<p style="text-align: center;">661.95 N OF F-4</p> <p>SET 5/8" X 34" REROD W/CAP & CED POST W/LOC TAG.</p> <p>9" R PINE S58°W 42.4'</p> <p>8" R PINE N58°W 42.1'</p> <p>DROVE 5/8" X 34" REROD W/RLS CAP. S89°30'W 300.0'</p> <p>CTR OF EXIST N-S EAST 28'</p> <p>B TOP RD</p>
---	--

- B. Description of corner evidence found and/or method applied in restoring or re-establishing corner:
- E-3 FD FARGO PINCH PIPE & BUTTER DISH (BROKEN) AT COR FN POST (DOWN), FN'S N-S-W AND IRREG, SE'LY, FITS RLS, J. WILCOX WITS.
 - E-5 FD & ACCEPTED ROUND CONC. MONUMENT FOR SW COR OF SEC 9. FITS RLS, J. WILCOX'S WITS.
 - 5 ESTAB NE COR OF E-300' OF N 1/2-SE 1/4-NW 1/4 OF SEC 9 MID-WAY & ON LINE BETW THE N 1/4 COR & CTR OF SEC 9.
 - *F-4 ESTAB SE COR OF THE E-300' OF N 1/2-SE 1/4-NW 1/4 OF SEC 9 MID-WAY & ON LINE BETW THE 1/8 COR TO N & CTR OF SEC TO S.

C. Description of monument for corner and accessories established to perpetuate locating the position of the corner:

<p style="text-align: center;">E-3</p> <p>FD 3/4" PIPE, REPLACED W/WEX CO. MON & SET CED POST W/LOC TAG.</p> <p>*12" TW MAP N08°W 9.32</p> <p>*13" TW ASH N74°E 13.03</p> <p>*18" BASSWD S20°E 25.08</p> <p>18" MAPLE S38°W 65.47</p> <p>*RLS J. WILCOX WITS</p>	<p style="text-align: center;">E-5</p> <p>FD ROUND CONC MON; ADDED CED POST W/LOC TAG.</p> <p>7" ASH N45°E 51.34</p> <p>**POWER POLE N82°E 3.54</p> <p>*12" BASSWD N74°W 41.37</p> <p>10" ASH S12°E 16.89</p> <p>E BANK WEST 65'±</p> <p>MANISTEE RVR.</p>
--	--


SIGNED BY Carl F. Roser 01-14-85 DATE _____

SURVEYOR'S MICHIGAN REGISTRATION NO. 12028

FOR STATE AND UNITED STATES AGENCIES:

SIGNED BY _____ DATE _____

APPROVED AND SIGNED BY _____ DATE _____

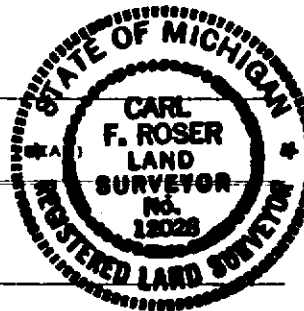

SURVEYOR'S MICHIGAN REGISTRATION NO. _____

GLENWOOD TWP.
WEXFORD COUNTY

FORM APPROVED BY MICHIGAN STATE BOARD OF REGISTRATION, JAN. 28, 1971
REVISED MAY 14, 1978

MAY PLACE SKETCH ON BACK OR ATTACHED SHEET