

**LAND CORNER RECORDATION CERTIFICATE**  
**Filing Requirement of Act 74, Mich. P.A. 1970**

For corners in  
HEXFORD

(County)

Located In:

Corner Code F-9

1. Public Land Survey	T	<u>24N</u>	R	<u>10W</u>	<u>F-9</u>
	T		R		
	T		R		
	T		R		
2. Property Controlling in Section	S	<u>21</u>	T	R	<u>6.9.16</u>
	S		T	R	
3. Miscellaneous Property in Sec.	S		T	R	
	S		T	R	

Register of Deeds Stamp & File Number

4. Lot No. \_\_\_\_\_, Recorded Plat \_\_\_\_\_  
 5. Private Claims \_\_\_\_\_

I, C.F. ROSER, in a field survey on APRIL 20, 19 89, do hereby certify that under requirements of P.A. 74, Michigan P.A. of 1970, the corner points mentioned in lines 1 and 2 above were in conformance with regulations and rules therefore as required in the current manual of survey instructions of the United States Department of the Interior, Bureau of Land Management or by a decree of a Court of Law and/or that the corner points mentioned in lines 3, 4 and 5 above were in conformance with the rules of the Michigan Board of Land Surveyors or by a Decree of a Court of Law; established, re-established, monumented, re-monumented, recovered, found as expressed below:

**NOTE: Not more than 4 corners, all in the same town and range, may be recorded on this certificate.**

	A	B	C	D	E	F	G	H	I	J	K	L	M
2	6	5	4	3	2	1							
3													
4	7	8	9	10	11	12							
5													
6	18	17	16	15	14	13							
7													
8	19	20	21	22	23	24							
9													
10	30	29	28	27	26	25							
11													
12	31	32	33	34	35	36							
13													

A. Description of original monument and accessories and/or subsequent restoration:

F-9

6

9

16

B. Description of corner evidence found and/or method applied in restoring or reestablishing corner:

F-9

6

9

16

SE 1/4 COR SEC 21 WAS ESTABLISHED BY PROPORTIONATE MEASUREMENT BETWEEN FOUND SEC CORNERS 1/2 MILE E & W IN 1962 DEPT SURVEY BY K. OSTLING.

ESTABLISHED CENTER OF NE 1/4 OF SEC 21 PER STANDARD B.L.M. INSTRUCTIONS.

ESTABLISHED SW COR OF SE 1/4 OF SEC 21 PER STANDARD B.L.M. INSTRUCTIONS.

E 1/8 COR ON S. LINE OF SEC 21 SET PER STANDARD B.L.M. INST. BY K. OSTLING IN 1962 DEPT. SURVEY. CTR OF N-S TRAIL RD IS 185' ± WEST.

C. Description of monument for corner and accessories established to perpetuate locating the position of the corner:

F-9

6

9

16

FD DEPT BRASS CAPPED MON & SET CEDAR POST.  
 \*10" CEDAR S09°W 3.6'  
 \*6" CEDAR N58°E 17.6'  
 6" CEDAR S78°E 2.7'  
 7" CEDAR N30°W 12.8'


DROVE 1/2" X 55" PIPE & SET CEDAR POST W/LOC TAG.  
 10" B. ASH N86°W 5.4'  
 3" IRONWOOD N34°E 21.6'  
 9" TAMARACK S38°E 9.7'  
 9" TAMARACK S40°W 6.3'

DROVE 3/8" X 80" PIPE W/LS CAP & SET CEDAR POST W/LOC TAG.  
 7" CEDAR N08°W 8.8'  
 12" TN. MAPLE N66°E 12.9'  
 8" R. MAPLE S34°E 12.6'  
 8" TN. CEDAR S30°W 12.9'

FD 1" PIPE & SET CEDAR POST W/LOC TAG.  
 \*24" W. PINE STP S56°W 59.6'  
 \*24" W. PINE STP N54°E 10.5'  
 4" W. PINE S10°E 19.1'  
 2" W. PINE N52°W 64.7'

\* = 1962 KJO DEPT. WITS.

Signed by Carl F. Roser 02-06-91  
 Surveyor's Michigan License No. 12028

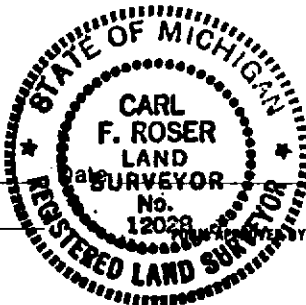

\* = 1962 KJO WITS.