LAND CORNER RECORDATION CERTIFICATE

Filing Requirement of Act 74, Mich. P.A. 1970

For corners in
WEXFORD
(County)

Located In: Corner Code 11

1. Public Land Survey	T 24N R 10W	F-7,F-8
	T ___ R ___	
	T ___ R ___	
	T ___ R ___	
2. Property Controlling	S 21 T ___ R ___	2,5
in Section	S ___ T ___ R ___	
3. Miscellaneous	S ___ T ___ R ___	
Property in Sec.	S ___ T ___ R ___	

Register of Deeds Stamp & File Number

4. Lot No. _____ , Recorded Plat _____
5. Private Claims _____

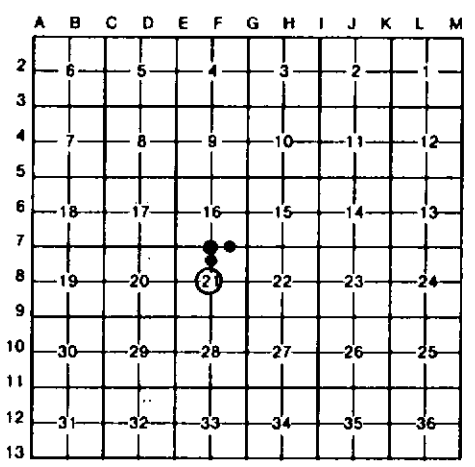

I, C.F.ROSER, in a field survey on APRIL,20, 19 89, do hereby certify that under requirements of P.A. 74, Michigan P.A. of 1970, the corner points mentioned in lines 1 and 2 above were in conformance with regulations and rules therefore as required in the current manual of survey instructions of the United States Department of the Interior, Bureau of Land Management or by a decree of a Court of Law and/or that the corner points mentioned in lines 3, 4 and 5 above were in conformance with the rules of the Michigan Board of Land Surveyors or by a Decree of a Court of Law; established, re-established, monumented, re-monumented, recovered, found as expressed below:

NOTE: Not more than 4 corners, all in the same town and range, may be recorded on this certificate.

A. Description of original monument and accessories and/or subsequent restoration:

E-7	F-8	2	5
N 1/4 COR SEC 21 REESTABLISHED BY PROPORTIONATE MEAS. BETWEEN FD. SECTION CORNERS 1/2 MILE E AND W IN 1962 DEPT SURVEY BY K.OSTLING. CTR. OF E-W GRAVEL RD IS NORTH 8'. WEX. CO MON FD FITS REMAINS OF ONE KJO WITS AND HIS PROPORTIONATE MEAS POSITION.	ESTABLISHED CENTER OF SEC. 21 AT INETERSECTION OF 1/4 LINES.	E 1/8 CORNER ON N LINE OF SEC 21 SET IN 1962 DEPT SURVEY BY K.OSTLING PER STANDARD B.L.M. INSTRUCTIONS. COR FALLS 1'± S. OF CTR E-W GRAVEL RD.	ESTABLISHED SW COR OF NW1/4 OF NE1/4 OF SEC 21 PER STANDARD B.L.M. INSTRUCTIONS.

B. Description of corner evidence found and/or method applied in restoring or reestablishing corner:

E-7	F-8	2	5

C. Description of monument for corner and accessories established to perpetuate locating the position of the corner:

E-7			F-8			2			5		
FD BOTTOM OF BROKEN OFF WEXFORD CO MON. 12" DEEP, RAISED WITH 8" CABIN SPIKE.			DROVE 1"X 5'± PIPE W/LS CAP & SET CED. POST W/LOC. TAG			FD 1/2" X 12" ROD. REPLACED WITH 5/8" X 34" REROD W/LS CAP			DROVE 1/2" X 4 1/2' PIPE AND SET CEDAR POST W/LOC TAG.		
13"MAPLE	N52°W	78.11'	5"CED.	N56°W	8.8'	*11" W.PINE	N54°W	79.0'	2"B.ASH	N40°E	13.6'
P.POLE	S38°E	34.28'	7"CED.	N46°E	6.1'	10" R.PINE	N38°E	52.32'	4"R.MAPLE	S72°E	19.4'
5"MAPLE	S35°W	66.18'	5"CED.	S32°E	8.6'	6" W.PINE	S30°W	54.6'	5"R.MAPLE	S22°W	21.6'
SET CEDAR POST			5"CED.	S70°W	5.1'	SET CEDAR POST			7"B.ASH	N56°W	7.0'
W/LOC TAG	SOUTH	33'				W/LOC TAG	SOUTH	33'			

* = 1962 KJO DEPT WIT.

Signed by Carl F. Roser 02-06-91 Date _____

Surveyor's Michigan License No. 12028

STATE OF MICHIGAN
CARL F. ROSER
LAND SURVEYOR
No. 12028
REGISTERED LAND SURVEYOR

FORM APPROVED BY MICHIGAN STATE BOARD OF LAND SURVEYORS, JAN. 18, 1971
REVISED MAY 20, 1975
REVISED JAN., 1983