

# LAND CORNER RECORDATION CERTIFICATE

## FILING REQUIREMENT OF ACT 74, MICH. P.A.1970

FOR CORNERS OF--:	LOCATED IN--:	CORNER CODE NUMBER
1. PUBLIC LAND SURVEY _____	T. 24 <sup>N.</sup> <input checked="" type="radio"/> R. 10 <sup>W.</sup> <input checked="" type="radio"/>	K-1; K-2; K-3
2. PROPERTY CONTROLLING IN SECTION <u>1</u>	T. 24 <sup>N.</sup> <input checked="" type="radio"/> R. 10 <sup>W.</sup> <input checked="" type="radio"/>	1
3. MISCELLANEOUS PROPERTY IN SECTION _____	T. _____ <sup>N.</sup> <input type="radio"/> <sup>S.</sup> <input type="radio"/> R. _____ <sup>E.</sup> <input type="radio"/> <sup>W.</sup> <input type="radio"/>	
4. LOT NO. _____, RECORDED PLAT _____		
5. PRIVATE CLAIMS _____		

REGISTER OF DEEDS STAMP AND FILING NUMBER

I, Carl F. Roser, do hereby certify that under requirements of P.A. 74, Michigan P.A. of 1970, the corner points mentioned in lines 1 and 2 above were, in a field survey on November 14, 1979, established, re-established, monumented, re-monumented, recovered or restored as expressed below and in conformance with regulations and rules therefore as required in the current manual of survey instructions of the United States Department of the Interior, Bureau of Land Management or by a decree of a court of law. Furthermore, that the corner points mentioned in lines 3, 4 and 5 above were, in a field survey on \_\_\_\_\_, 19\_\_\_\_, found, recovered, restored, established or re-established as expressed below and in conformance with the rules of the Michigan State Board of Registration for Land Surveyors or, by a Decree of a Court of law:

~~A. Description of original monument and accessories and/or subsequent restoration:~~

C. (continued)

1  
Drove 5/8"x36" rerod & set cedar post w/loc. tag.  
5" Maple S83°W 33.0  
6" Maple N55°E 22.9  
5" Maple S15°E 32.0  
Fd. Schaaf Pipe  
S54°43'W 6.28

B. Description of corner evidence found and/or method applied in restoring or re-establishing corner:


- K-1 Fd. lower Fargo butter dish & stake shadow from 36" w. pine stump remains (Fargo), S40°W, 38.6'. Fargo (1913) & Schaaf (1937) call this a good original (resurvey) U.S. corner. Random line to east is 3.2' south & corner is on random line to south.
- K-2 Found Wexford County monument and Fargo pipe.
- K-3 Fd. 1/2"x24" rerod w/RLS cap #21265, Consumers Power Co. surveyor. Also fd. 1"x24" rerod and plow point. Manistee River is southerly 150±'.
- 1 Set 1/8 corner per standard B.L.M. instructions.

C. Description of monument for corner and accessories established to perpetuate locating the position of the corner:

K-1	K-2	K-3
Fd. Fargo cor.; replaced w/std. Wex. Co. mon. & ced. post w/loc. tag.	Fd. Fargo pipe & Wex. Co. mon. added cedar post w/loc. tag.	Fd. rerod; replaced w/Wex. Co. mon. & set ced. post w/loc. tag.
7" W. Pine S40°W 35.0	5" W. Oak N18°E 41.00	23" W. Pine N78°W 96.3
10" Maple S40°E 50.0	4" R. Oak S82°E 10.41	9" W. Birch N70°E 41.05
13" Twn.R.Pine N60°E 86.1	6" Twn.Maple S55°E 51.88	27" W. Pine S57°E 75.6
⊕ E-W Trl.Rd. Due N 10'± (in curve)	N-S Random Due W 14.2'	28" W. Pine N73°W 89.41

SIGNED BY Carl F. Roser

DATE 1-30-80

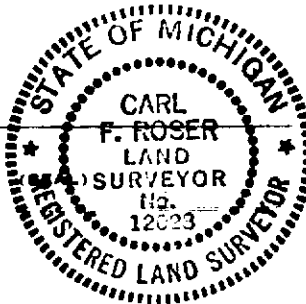

SURVEYOR'S MICHIGAN REGISTRATION NO. 12028

FOR STATE AND UNITED STATES AGENCIES:

SIGNED BY \_\_\_\_\_ DATE \_\_\_\_\_

CHIEF OF SURVEY PARTY

APPROVED AND SIGNED BY \_\_\_\_\_ DATE \_\_\_\_\_

MICHIGAN REGISTERED LAND SURVEYOR

(SEAL)

SURVEYOR'S MICHIGAN REGISTRATION NO. \_\_\_\_\_

GREENWOOD TOWNSHIP  
WEXFORD COUNTY