

L. 9, P. 64

1/16/2020

Land Corner Recordation Certificate

Authority: 1970 PA 74, MCL 54.205

Surveyor's Name: Craig W. McVean

Field Survey Date: Aug. 19, 2019

For corner(s) in: Wexford County

Original Public Land Survey Corner			Corner Code
S _____	T _____	R _____	_____
S _____	T _____	R _____	_____
S _____	T _____	R _____	_____
S _____	T _____	R _____	_____

Property Controlling Corner			Corner Code
S _____	T _____	R _____	_____
S _____	T _____	R _____	_____
S _____	T _____	R _____	_____
S _____	T _____	R _____	_____

Property Corner			Corner Code
S <u>21</u>	T <u>24N</u>	R <u>10W</u>	<u>10</u>
S <u>21</u>	T <u>24N</u>	R <u>10W</u>	<u>11</u>
S _____	T _____	R _____	_____
S _____	T _____	R _____	_____

Protracted Public Land Survey Corner			Corner Code
S _____	T _____	R _____	_____
S _____	T _____	R _____	_____
S _____	T _____	R _____	_____
S _____	T _____	R _____	_____

	A	B	C	D	E	F	G	H	I	J	K	L	M	
1														1
2	6		5		4		3		2		1			2
3														3
4	7		8		9		10		11		12			4
5														5
6	18		17		16		15		14		13			6
7														7
8	19		20		21		22		23		24			8
9														9
10	30		29		28		27		26		25			10
11														11
12	31		32		33		34		35		36			12
13														13
	A	B	C	D	E	F	G	H	I	J	K	L	M	

Part A: Corner History

10 – S 1/16 Corner common to Section 20 & 21, T24N, R10W-
 - 1962 – K. J. Ostling (PS # 10068) – LCRC
 L. 3, p. 47 (1977) – Set 1" x 24" pipe midpoint on line between ¼ and section corner. Falls about 13 links west of fence corner E & N.
 1) BT 6" Cedar S72°E 5.1'
 2) BT 7" Cedar S88°W 5.8'

11 – SW 1/16 Corner Sec. 21, T24N, R10W
 - None

Part B: Surveyor's Report on Perpetuation, Restoration, Reestablishment, or Monumentation of Corner


10 – S 1/16 Corner common to Sections 20 & 21, T24N, R10W
Found 1" I.D. iron pipe per Ostling at E'ly edge of Cedar swamp. Remain of N-S fence on ground mostly is 7'± East. Centerline N-S 2-track is 134'± East. Steel 'T' fence post is 0.45' W'ly. Condition of witnesses as follows: #1 – Stump tipped up; #2 – OK. 1" pipe accepted as the best available evidence of the position of the corner.

11 – SW 1/16 Corner Sec. 21, T24N, R10W
Set 2" Aluminum Cap on 5/8" x 34" long iron rebar per Standard BLM procedure.

Part C: Field Evidence of Perpetuation or Monumentation of Corner

10 – S 1/16 Corner common to Sections 20 & 21, T24N, R10W
Drove stamped 2" Aluminum Cap on 5/8" x 34" long iron rebar into center of found 1" iron pipe.
Set Blue Composite Post with loc. tag 1' SE
S58°E 5.95' to set N & T in N. side 13" R. Maple
S86°W 6.12' to set N & T in N. side 8" Cedar (#2)
N25°W 18.79' to set N & T in E. side 11" Red Maple
N43°E 21.06' to set N & T in NW side 12" Hemlock

11 – SW 1/16 Corner Sec. 21, T24N, R10W
Stamped 2" Aluminum Cap on 5/8" x 34" long iron rebar.
Set Blue Composite Post with Loc. Tag 1' SE.
N10°E 5.97' to set N & T in W. side Tw. 14" & 6" R. Maple
N89°E 24.67' to set N & T in N. side 13" Red Maple
S20°W 7.89' to set N & T in W. side Tw. 9" Red Maple
N87°W 36.76' to set N & T in S. side Tw. 7" & 11" Red Maple

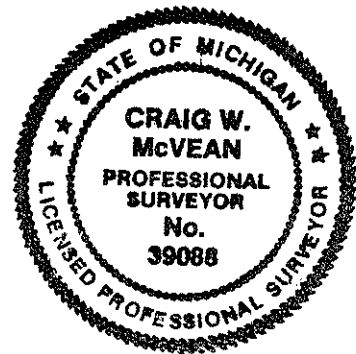

Craig W. McVean

Craig W. McVean

1/15/2020

Date

Professional Surveyor's License No.: 39088

Prepared By:
Craig W. McVean
Michigan Dept. of Natural Resources
8015 Mackinaw Trail
Cadillac, Michigan 49601