

SURVEY & REMONUMENTATION

APR 25 1995

COMMISSION LAND CORNER RECORDATION CERTIFICATE

Filing Requirement of Act 74, Mich. P.A. 1970

RECEIVED

1994 DEC -9 PM 4: 24

Linda Laughmiller
WEXFORD COUNTY, MI
REGISTERED CLERK

For corners in

Wexford

(County)

Located In:

Corner Code #

- | | | | |
|------------------------------------|---------------------------|-------------|-------|
| 1. Public Land Survey | T <u>24N</u> R <u>10W</u> | <u>A-13</u> | |
| | T _____ R _____ | _____ | _____ |
| | T _____ R _____ | _____ | _____ |
| | T _____ R _____ | _____ | _____ |
| 2. Property Controlling in Section | S _____ T _____ R _____ | _____ | _____ |
| | S _____ T _____ R _____ | _____ | _____ |
| 3. Miscellaneous Property in Sec. | S _____ T _____ R _____ | _____ | _____ |
| | S _____ T _____ R _____ | _____ | _____ |

Register of Deeds Stamp & File Number

4. Lot No. _____, Recorded Plat _____
5. Private Claims _____

	A	B	C	D	E	F	G	H	I	J	K	L	M
2	6		5		4		3		2		1		
3													
4	7		8		9		10		11		12		
5													
6	18		17		16		15		14		13		
7													
8	19		20		21		22		23		24		
9													
10	30		29		28		27		26		25		
11													
12	31		32		33		34		35		36		
13													

I, George D. Smith, in a field survey on June 28, 1994, do hereby certify that under requirements of P.A. 74, Michigan P.A. of 1970, the corner points mentioned in lines 1 and 2 above were in conformance with regulations and rules therefore as required in the current manual of survey instructions of the United States Department of the Interior, Bureau of Land Management or by a decree of a Court of Law and/or that the corner points mentioned in lines 3, 4 and 5 above were in conformance with the rules of the Michigan Board of Land Surveyors or by a Decree of a Court of Law; established, re-established, monumented, re-monumented, recovered, found as expressed below:

NOTE: Not more than 4 corners, all in the same town and range, may be recorded on this certificate.

A. Description of original monument and accessories and/or subsequent restoration:

- A-13) 1838 GLO Section post by John Brink, Deputy Surveyor, Beech 10 S 10° W 21', Beech 9 N 12 1/2° W 19'
- A-13) 1886 A.J. Teed, Liber 1, page 284, survey in Section 6, T23N, R10W, Corner found (no description given) Sugar 10 N 19 1/4° E 31'
- A-13) 1975 Roser LCRC, Liber 02, page 780, Found 3/4" Iron and in the same position as recovered by the Department in 1969, corner fence post S 5° E 37.2', 5" Maple N 44° E 46.65', 9" Maple N 5° E 34.59'
- A-13) 1993 Wilcox Certificate of Survey, Liber 73, page 481, Found 1/2" Iron, N 6° E 34.39' 8" Maple, N 43° E 43.98' 7" Maple, S 12° W 36.96' 8" Maple, N 64° E 66.62' 13" Maple


B. Description of corner evidence found and/or method applied in restoring or reestablishing corner:

Found 1/2" Iron and cap #14012 next to bent DNR monument (top broken off) in centerline road East-West and 6' East of fence line to South. This corner is accepted as a careful and faithful perpetuation of the position of the original corner, being the Section corner common to Section 31, T24N, R10W, Section 36, T24N, R11W, Section 6, T23N, R10W and Section 1, T23N, R11W.

C. Description of monument for corner and accessories established to perpetuate locating the position of the corner:

Set 5/8" x 36" Iron with Wexford County brass cap stamped SW 31, 1994 PS 33989, next to bent pipe

- N 6° E - 34.39' - 8" Maple
- N 43° E - 43.98' - 7" Maple
- S 12° W - 36.96' - 8" Maple
- N 64° E - 66.62' - 13" Maple

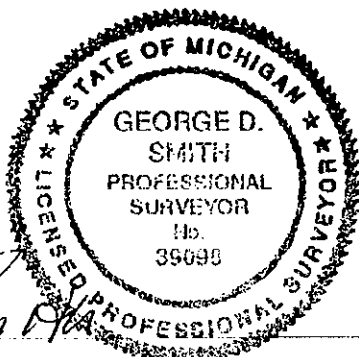

Peer Group Reviewed and Approved

Date: 12-2-94
Richard D. Wilcox
Richard D. Wilcox, Wexford County Surveyor

LIBER 004 PAGE 325

Signed by *George D. Smith*
Surveyor's Michigan License No. 39098

Date 11/29/94