

**SURVEY &
REMONUMENTATION**

APR 25 1995

COMMISSION LAND CORNER RECORDATION CERTIFICATE
Filing Requirement of Act 74, Mich. P.A. 1970

RECEIVED

1994 NOV 23 PM 3:53

Linda Loughmiller
WEXFORD COUNTY, MI
REGISTER OF DEEDS

For corners in

<u>Wexford</u> (County)	Located in:	Corner Code #
1. Public Land Survey	T <u>24N</u> R <u>10W</u>	<u>C-13</u>
	T _____ R _____	_____
	T _____ R _____	_____
	T _____ R _____	_____
2. Property Controlling in Section	S _____ T _____ R _____	_____
	S _____ T _____ R _____	_____
3. Miscellaneous Property in Sec.	S _____ T _____ R _____	_____
	S _____ T _____ R _____	_____
4. Lot No. _____, Recorded Plat _____		
5. Private Claims _____		

Register of Deeds Stamp & File Number

	A	B	C	D	E	F	G	H	I	J	K	L	M
2	6	5	4	3	2	1							
3													
4	7	8	9	10	11	12							
5													
6	18	17	16	15	14	13							
7													
8	19	20	21	22	23	24							
9													
10	30	29	28	27	26	25							
11													
12	31	32	33	34	35	36							
13													

I, George D. Smith, in a field survey on July 5 19 94, do hereby certify that under requirements of P.A. 74, Michigan P.A. of 1970, the corner points mentioned in lines 1 and 2 above were in conformance with regulations and rules therefore as required in the current manual of survey instructions of the United States Department of the Interior, Bureau of Land Management or by a decree of a Court of Law and/or that the corner points mentioned in lines 3, 4 and 5 above were in conformance with the rules of the Michigan Board of Land Surveyors or by a Decree of a Court of Law; established, re-established, monumented, re-monumented, recovered, found as expressed below:

NOTE: Not more than 4 corners, all in the same town and range, may be recorded on this certificate.

- A. Description of original monument and accessories and/or subsequent restoration:
- C-13) 1838 GLO Section post by John Brink, Deputy Surveyor, Sugar 20 N 12 1/2 E 34, Hemlock 10 N 46 W 18
 - C-13) 1852 GLO Subdivision of Section 6 & 5, T23N, R10W by L.S. Scrautor, Deputy Surveyor, Sugar 24 S 40 W 21, Sugar 18 S 36 E 37
 - C-13) 1886 A.J. Teed survey in Section 6, T23N, R10W, Liber 1, page 284, Found corner, no description or witnesses given
 - C-13) 1975 Roser LCRC, Liber 2, page 782, Found 3/4" bolt and added 1" x 24" pipe in centerline East-West road, in line with fence to North, corner is believed to be at same position as Devoe corner recovered by A.J. Teed in 1886, 14" Maple N 46 E 81.0', Location post North 33.0', 5" Red Pine N 51 W 54.66', centerline of black top road South, Due West 2'.

B. Description of corner evidence found and/or method applied in restoring or reestablishing corner:

A. con't)


- C-13) 1986 J.L. Wilcox Certificate of Survey, Liber 2, page 194, Found 1" pipe

B.

Found 1" x 24" pipe in centerline of road East-West and 2' East of centerline road South. This corner is accepted as a careful and faithful perpetuation of the position of the original corner, being the Section corner common to Sections 31 and 32, T24N, R10W and Sections 5 and 6, T23N, R10W.

C. Description of monument for corner and accessories established to perpetuate locating the position of the corner:
Set 5/8" x 36" Iron with Wexford County brass cap stamped SE 31, 1994, PS #33989 in center of pipe

- S 52° W - 67.91' - Corner fence post
- N 18° W - 39.27' - 7" Red Pine
- N 36° E - 37.57' - 5" Red Pine
- N 41° E - 81.02' - 20" Maple
- N 2° E - 44.67' - 5" Red Pine
- N 2° E - 33'± - Loc. post

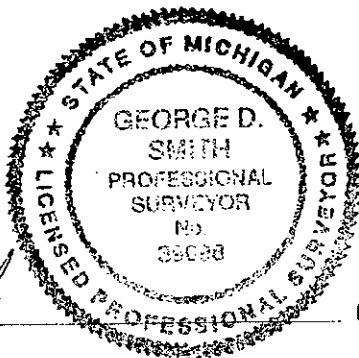

Peer Group Reviewed and Approved

Date: 11-21-94
Richard D. Wilcox
Richard D. Wilcox, Wexford County Surveyor

Signed by George D. Smith
Surveyor's Michigan License No. 39098

Date 11/17/94