

**SURVEY &
REMONUMENTATION**

APR 25 1995

RECEIVED

1994 NOV 23 PM 3: 53

COMMISSION LAND CORNER RECORDATION CERTIFICATE

Filing Requirement of Act 74, Mich. P.A. 1970

For corners in

Wexford
(County)

Located In:

Corner Code #

- | | | |
|------------------------------------|---------------------------|-------------|
| 1. Public Land Survey | T <u>24N</u> R <u>10W</u> | <u>D-13</u> |
| | T _____ R _____ | _____ |
| | T _____ R _____ | _____ |
| | T _____ R _____ | _____ |
| 2. Property Controlling in Section | S _____ T _____ R _____ | _____ |
| | S _____ T _____ R _____ | _____ |
| 3. Miscellaneous Property in Sec. | S _____ T _____ R _____ | _____ |
| | S _____ T _____ R _____ | _____ |

Linda Loughmiller
WEXFORD COUNTY, MI
REGISTER OF DEEDS

Register of Deeds Stamp & File Number

4. Lot No. _____, Recorded Plat _____
5. Private Claims _____

	A	B	C	D	E	F	G	H	I	J	K	L	M
2	6		5		4		3		2		1		
3													
4	7		8		9		10		11		12		
5													
6	18		17		16		15		14		13		
7													
8	19		20		21		22		23		24		
9													
10	30		29		28		27		26		25		
11													
12	31		32		33		34		35		36		
13													

I, George D. Smith, in a field survey on July 5, 1994, do hereby certify that under requirements of P.A. 74, Michigan P.A. of 1970, the corner points mentioned in lines 1 and 2 above were in conformance with regulations and rules therefore as required in the current manual of survey instructions of the United States Department of the Interior, Bureau of Land Management or by a decree of a Court of Law and/or that the corner points mentioned in lines 3, 4 and 5 above were in conformance with the rules of the Michigan Board of Land Surveyors or by a Decree of a Court of Law; established, re-established, monumented, re-monumented, recovered, found as expressed below:

NOTE: Not more than 4 corners, all in the same town and range, may be recorded on this certificate.

A. Description of original monument and accessories and/or subsequent restoration:

- D-13) 1838 GLO Quarter Section post by John Brink, Deputy Surveyor, Hemlock 10 N 52° E 28, Sugar 10 N 27° W 16
- D-13) 1975 Roser LCRC, Liber 02, page 780, Found and accepted 1" x 36" pipe in East-West road and in line with old fence to North and new fence to South, center East-West gravel road due North 2.5', 5" S. Pine N 32° W 56.25'


B. Description of corner evidence found and/or method applied in restoring or reestablishing corner:

Found 1" pipe ±2' South of centerline of East-West road and in fence lines North-South. This corner is accepted as a careful and faithful perpetuation of the position of the original corner, being the 1/4 corner common to Section 32, T24N, R10W and Section 5, T23N, R10W.

C. Description of monument for corner and accessories established to perpetuate locating the position of the corner:

Set 5/8" x 36" Iron with Wexford County brass cap stamped S 1/4 32, 1994 PS 33989 next to pipe at correct location

- N 1° W - 39.10' - Twin 3" Ash
- S 19° W - 72.88' - 6" Red Pine
- S 43° W - 95.40' - 7" Red Pine
- S 61° W - 87.53' - 7" Red Pine
- North - 32.7' - Face of loc. post with tag

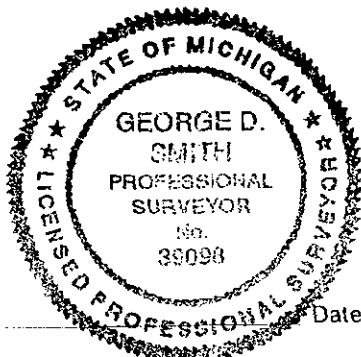

Peer Group Reviewed and Approved
Date: 11-21-94
Richard D. Wilcox
Richard D. Wilcox, Wexford County Surveyor

Signed by George D. Smith
Surveyor's Michigan License No. 39098

Date 11/17/94